
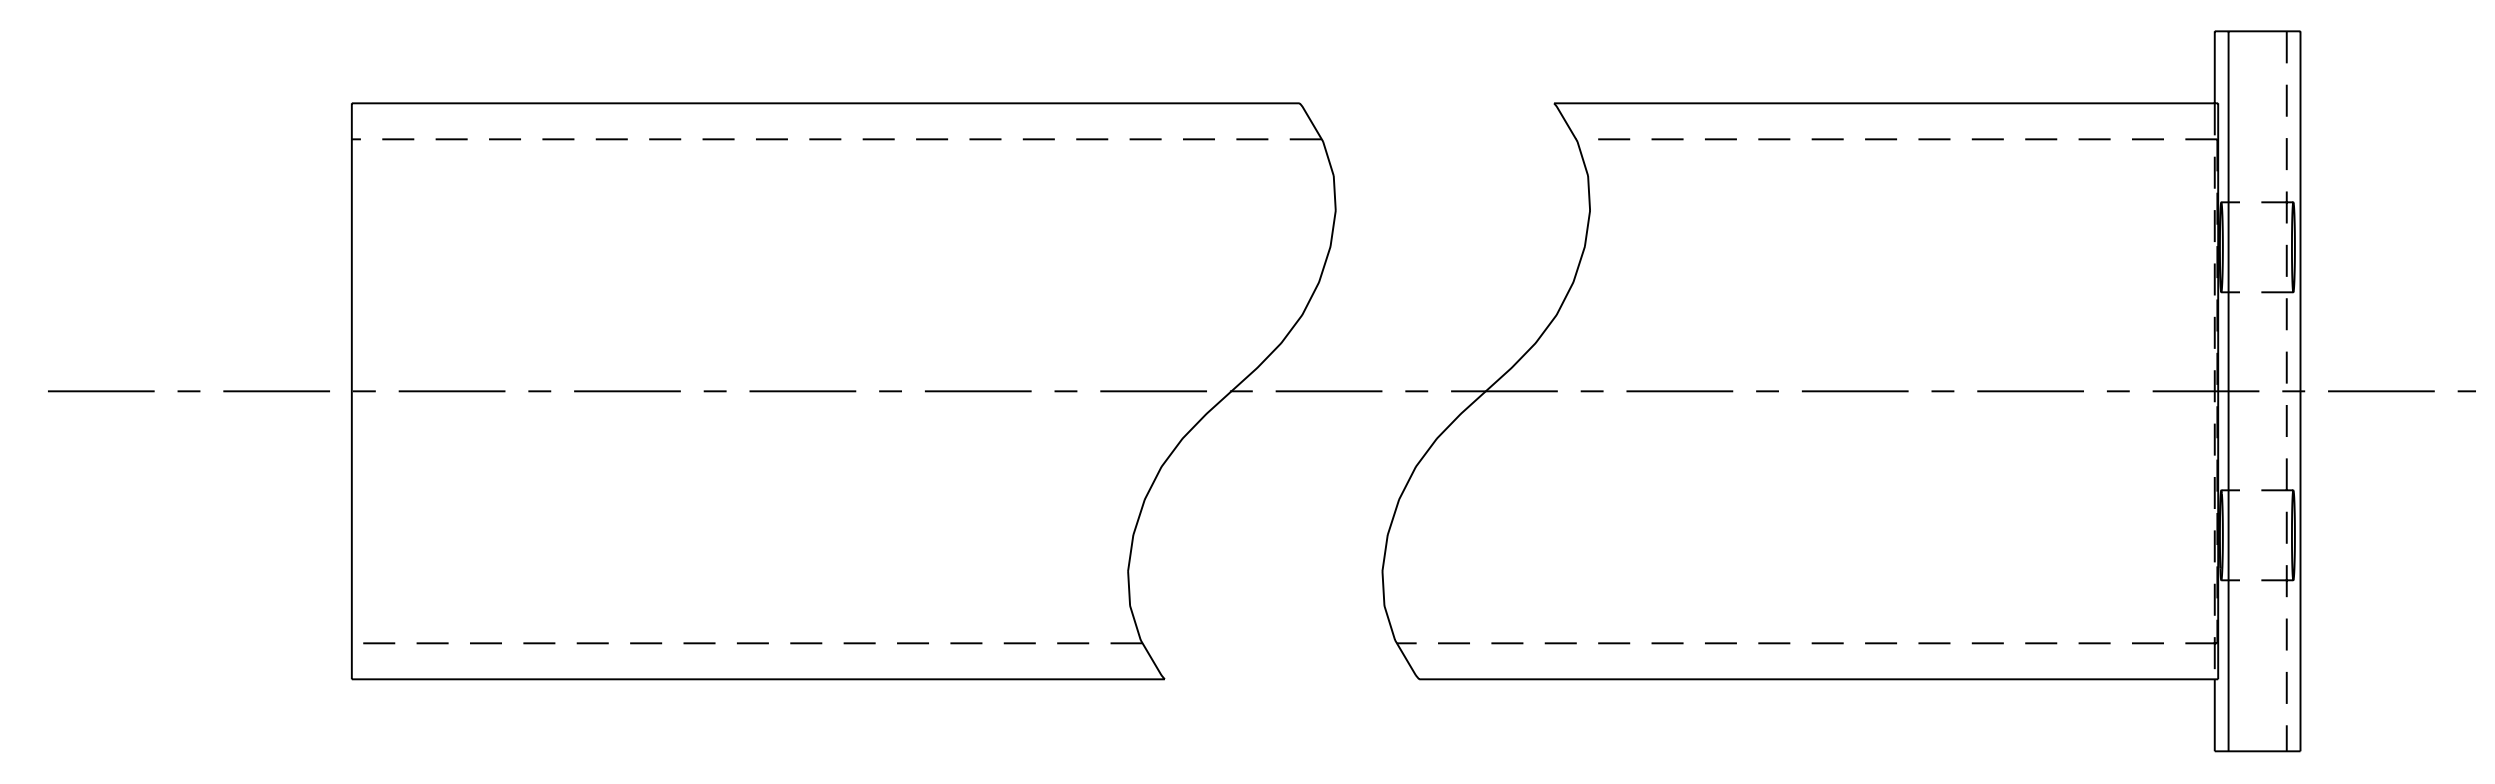
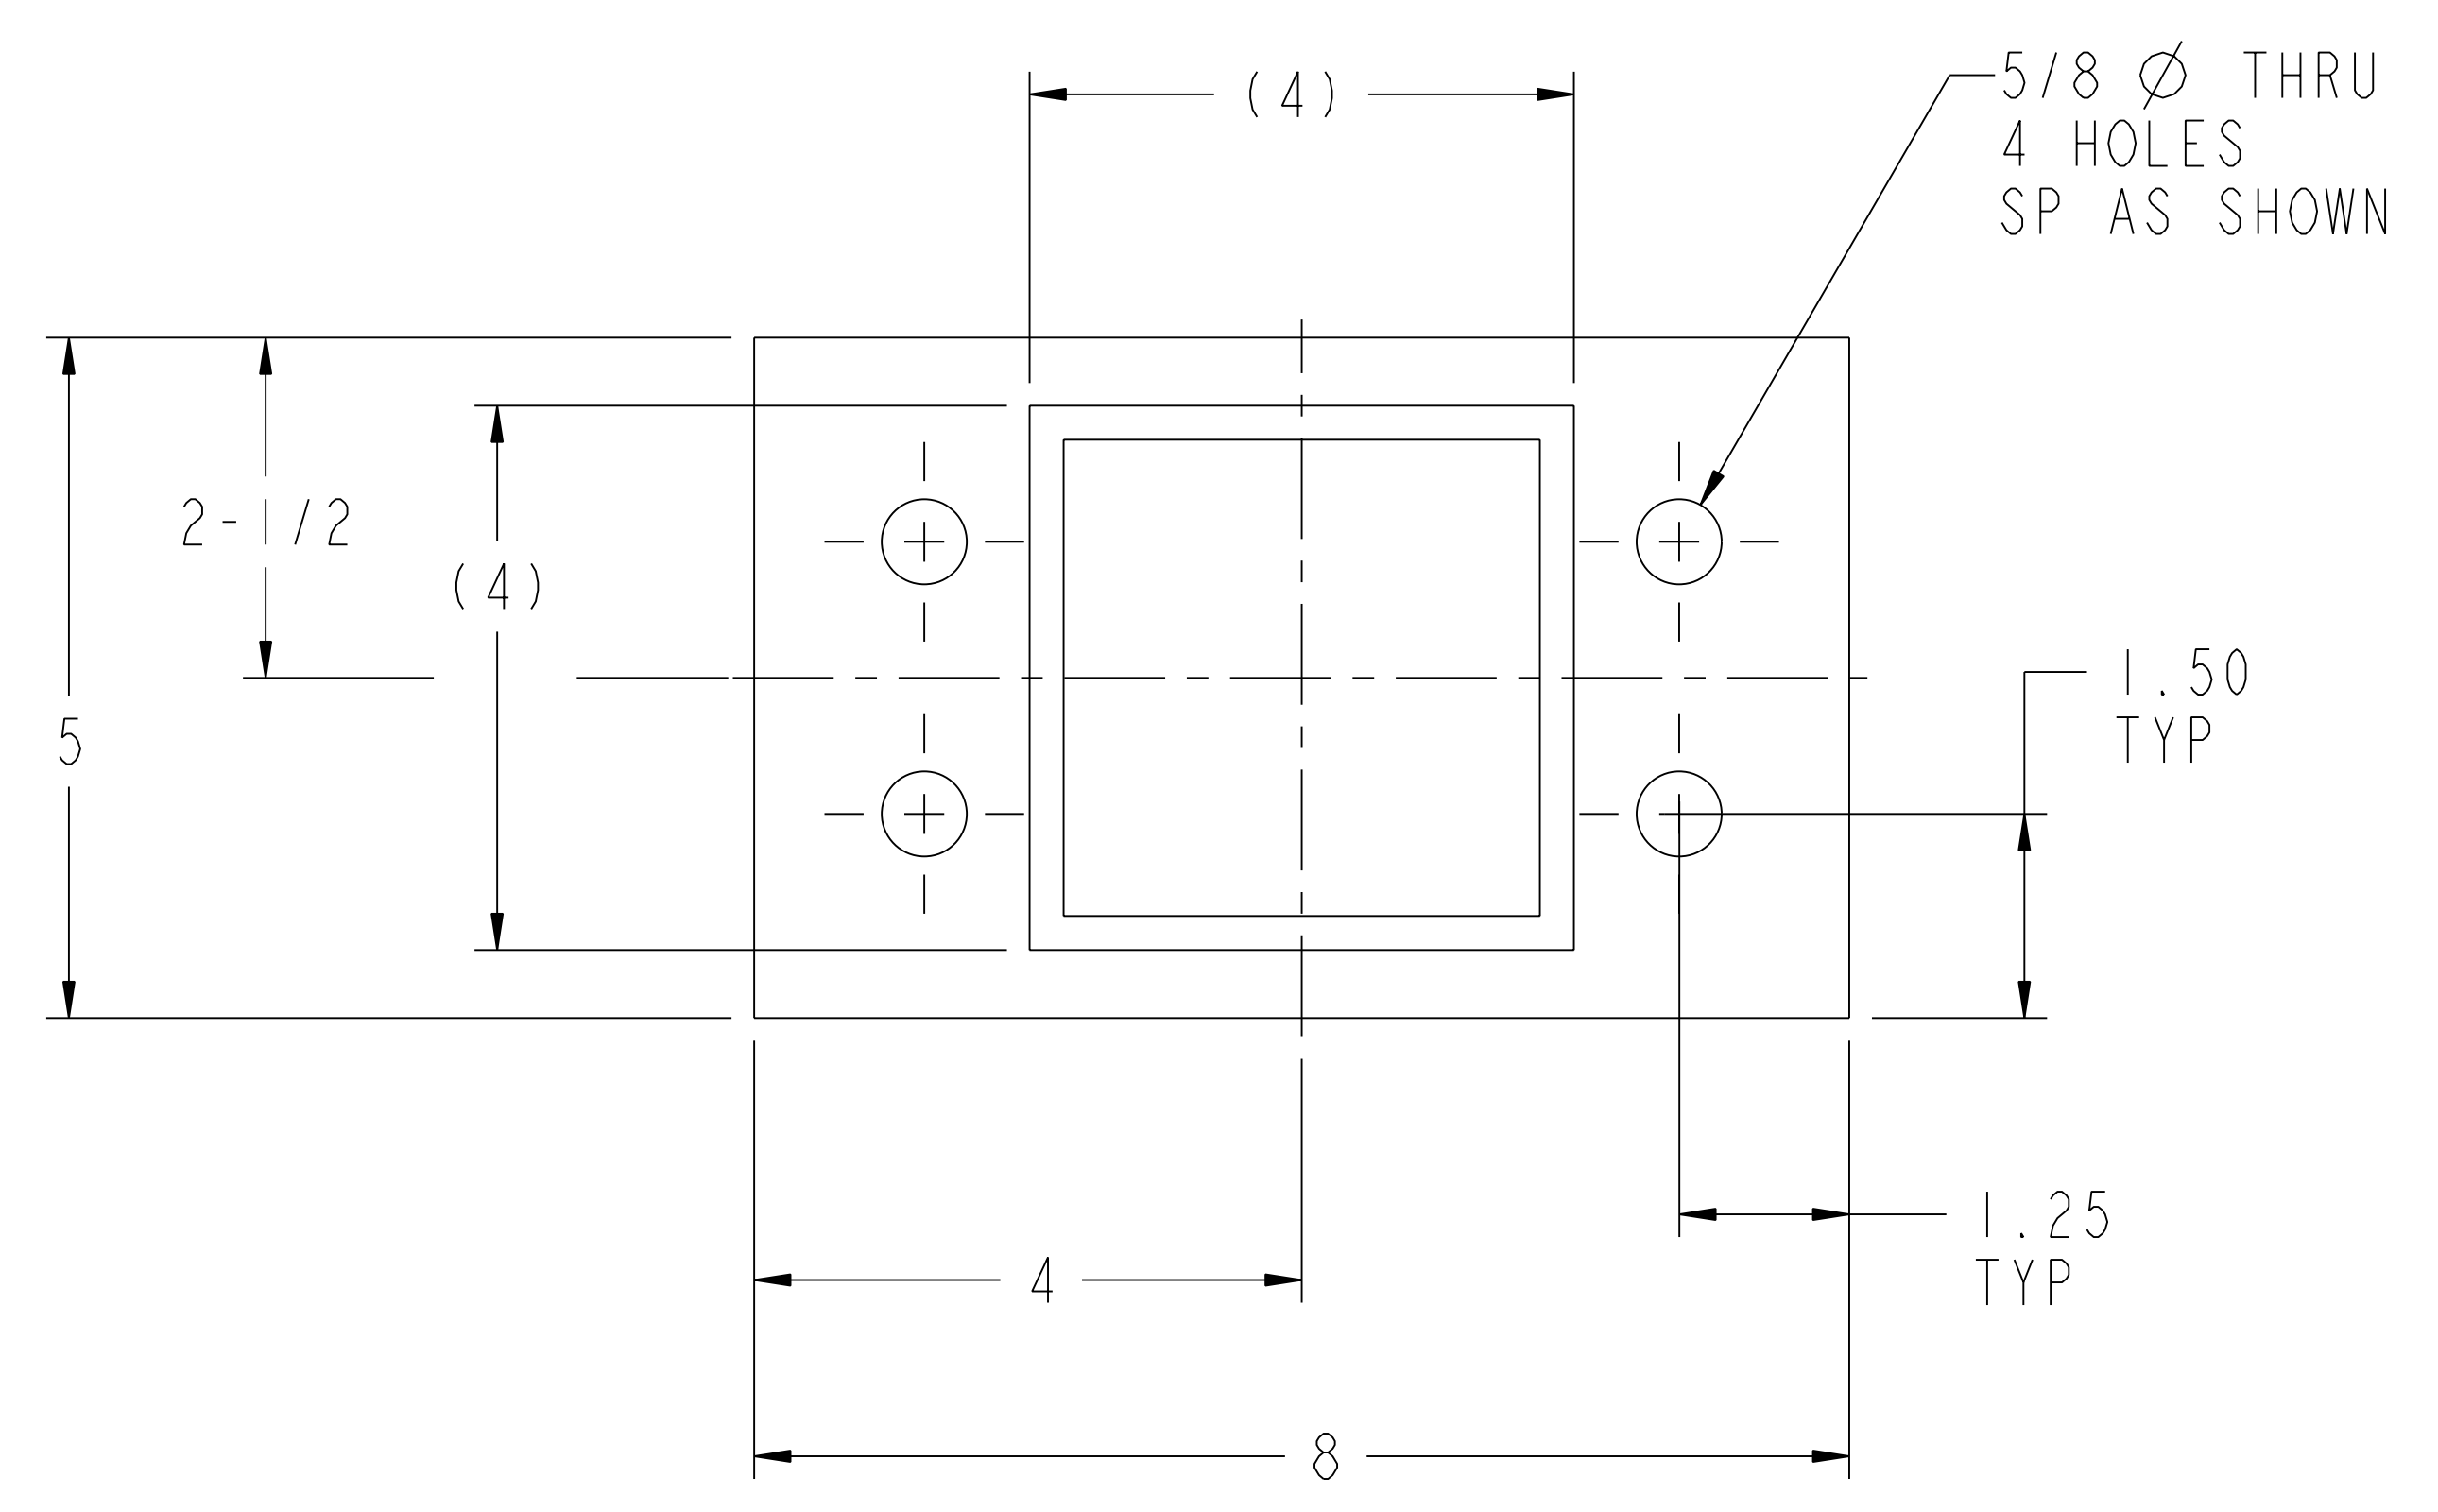
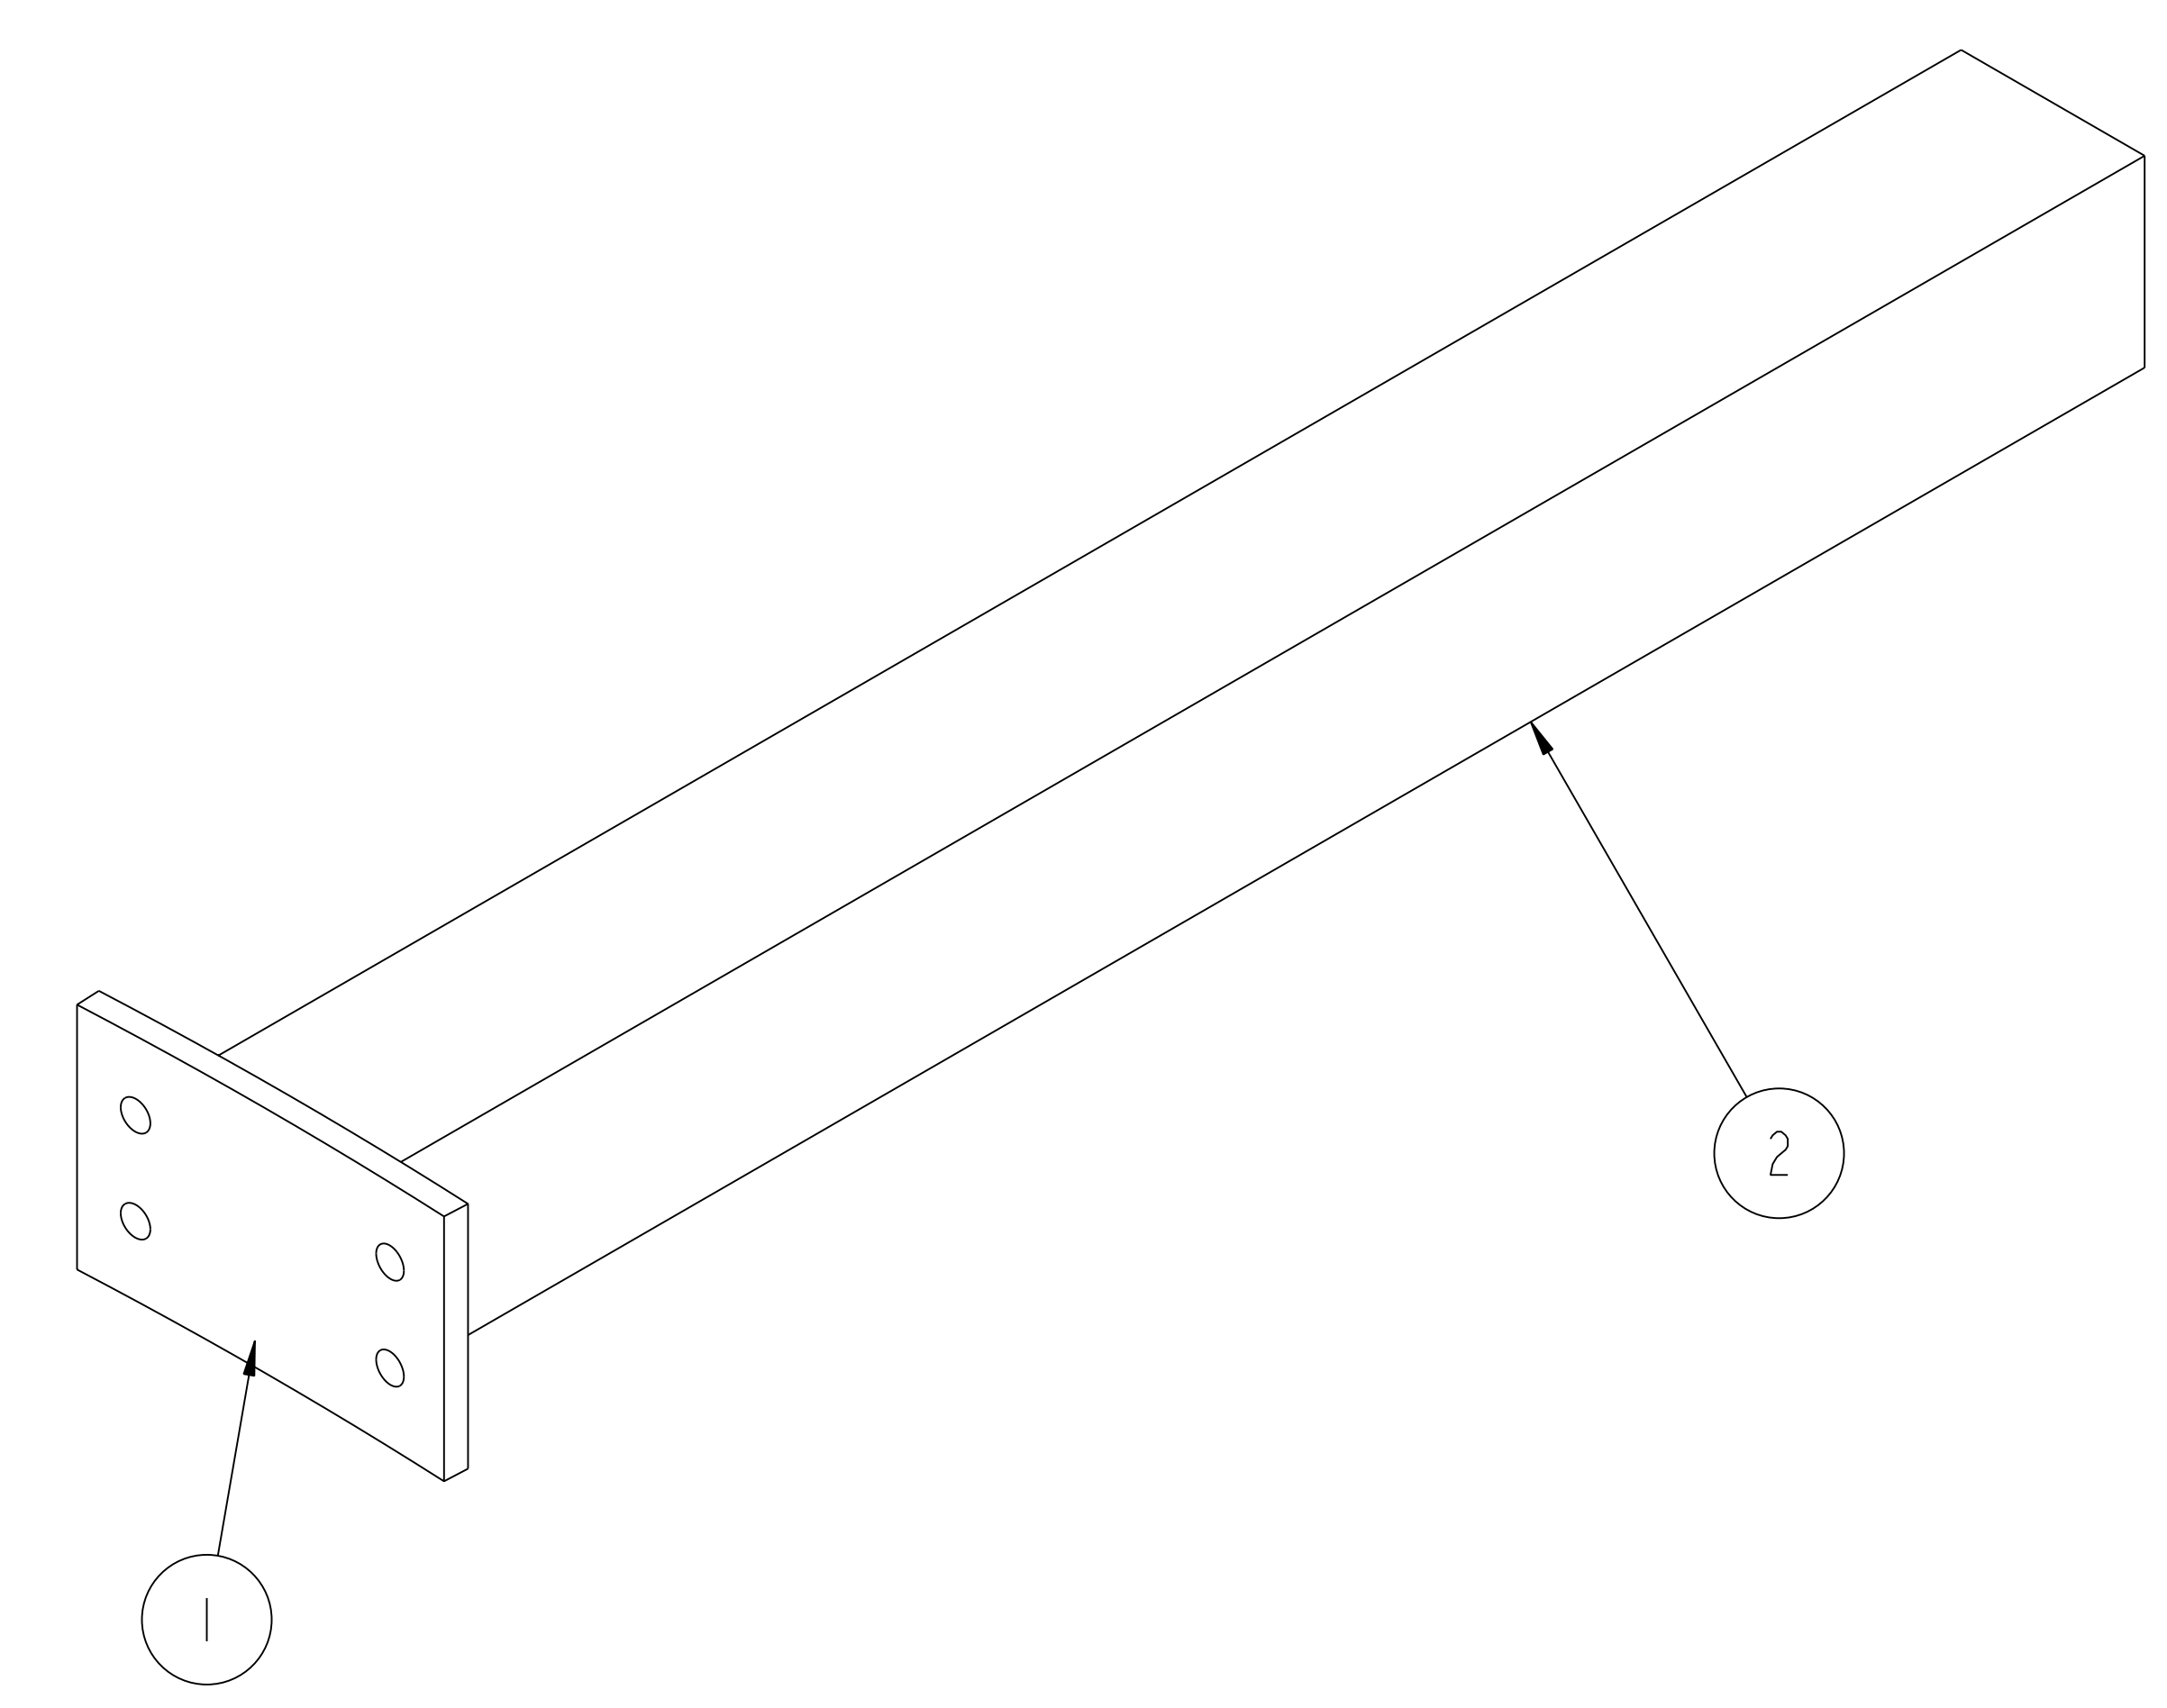


NOTE

1. WELDING SHALL BE PERFORMED IN ACCORDANCE WITH PPPL PROCEDURE EM-002.
2. VISUAL WELD INSPECTION SHALL BE PERFORMED IN ACCORDANCE WITH ACCEPTANCE CRITERIA OF ASME B31.3 CATEGORY "D".
3. NOTE ORIENTATION OF ALL PARTS BEFORE WELDING.

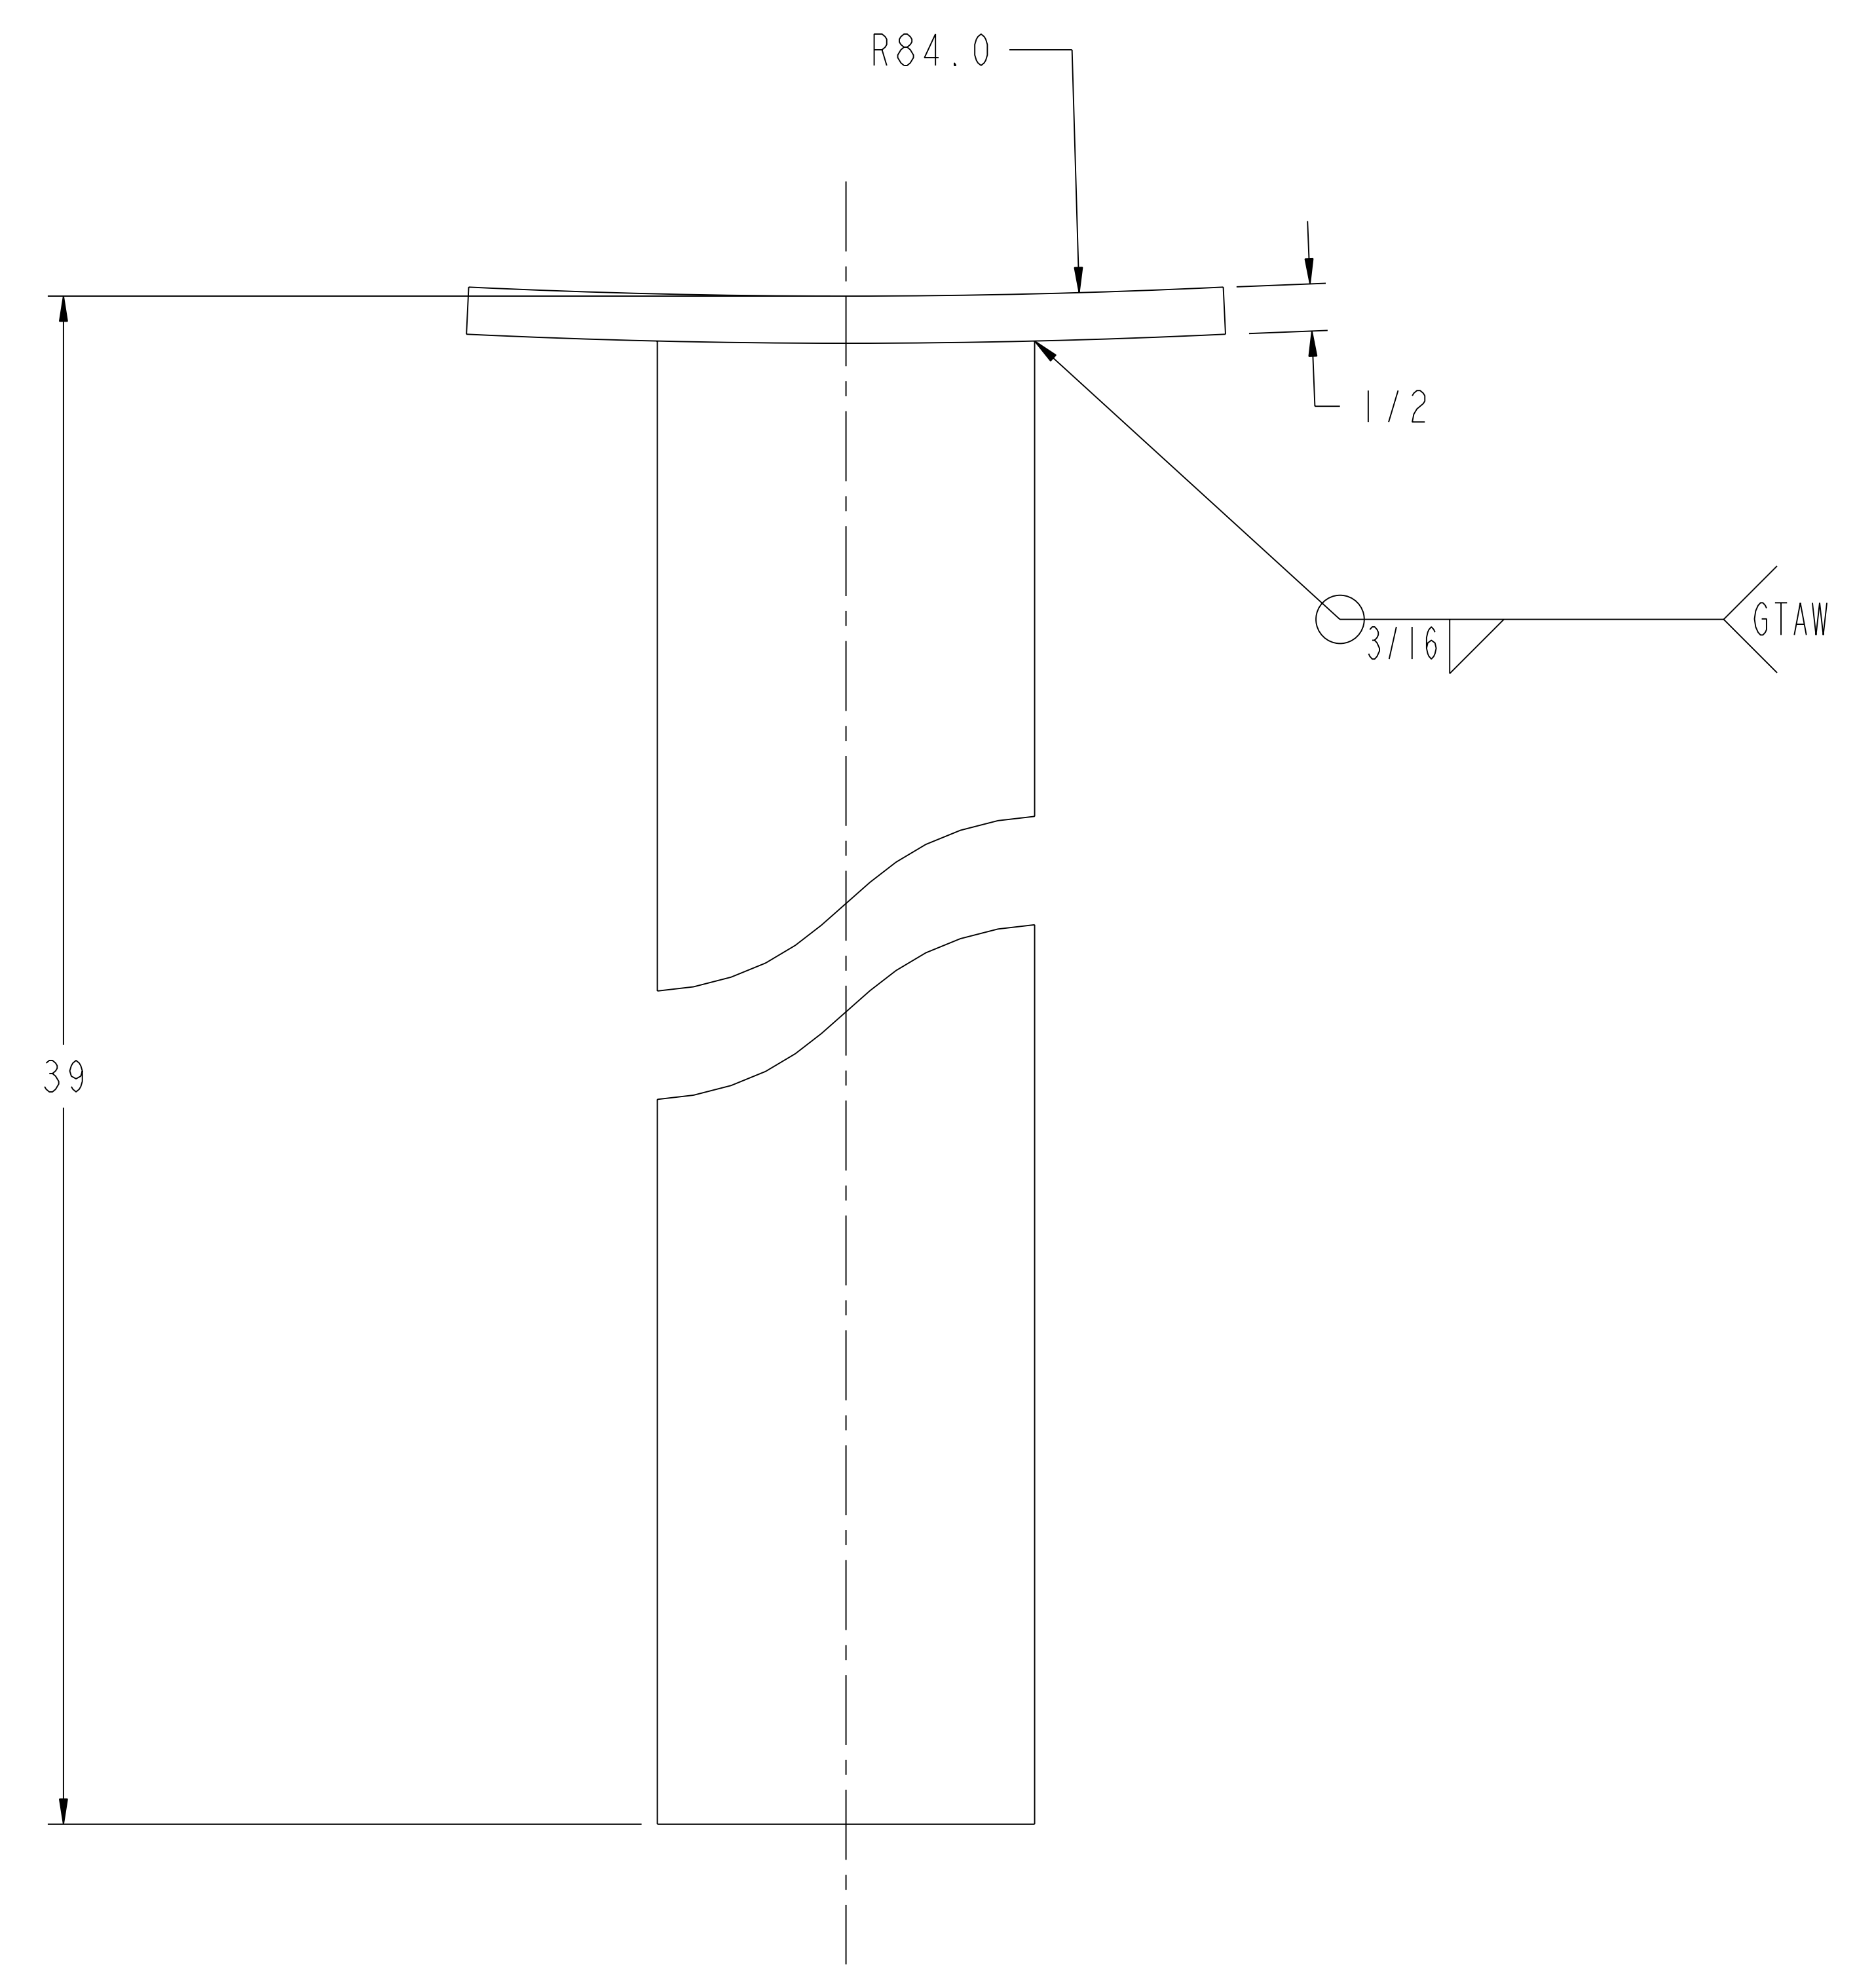

RELEASED FOR FABRICATION / INSTALLATION
PPPL Drafting:

2	SE144-361	PLATFORM SUPPORT RADIAL BOX BEAM 4 X 4 X 1/4	STN STL	1
1	SE144-359	PLATFORM SUPPORT BEAM MOUNTING PLATE	STN STL	1
PART NO.	DRAWING NO	NOMENCLATURE OR DESCRIPTION	MATERIAL	QTY REOD
PARTS LIST				
COMPUTER GENERATED DRAWING MANUAL CHANGES NOT PERMITTED		CENTRAL FILES: UNLESS OTHERWISE SPECIFIED	PRINCETON PLASMA PHYSICS LABORATORY PRINCETON UNIVERSITY	
Pro E		DIMENSIONS ARE IN INCHES MACHINE SURFACES	NATIONAL COMPACT STELLARATOR EXPERIMENT	
DO NOT VERIFY INFORMATION BY SCALING DRAWING		BREAK SHARP EDGES .005/.020	STELLARATOR CORE MODULAR COIL WINDING FACILITY AUTOCLAVE PLATFORM RADIAL SUPPORT BEAMS	
NEXT ASSEMBLY		TOLERANCES NON-CUMULATIVE DECIMAL-INCH FRACTIONS	DSN: J. RUSHINSKI	DRAWING NO:
RELEASE LEVEL: As Built		WELDING SCANNER	CHK: J. CHRZANOWSKI	SE144-360
DWG VERSION NO:		0.750	ENGR: S. RAFTOPOULOS	SHEET 1 OF 1
			SUPV: J. SIEGEL	REV 0

RELEASE LEVEL: As Built
DWG VERSION NO: 0.750

NCSX-SE144-360