
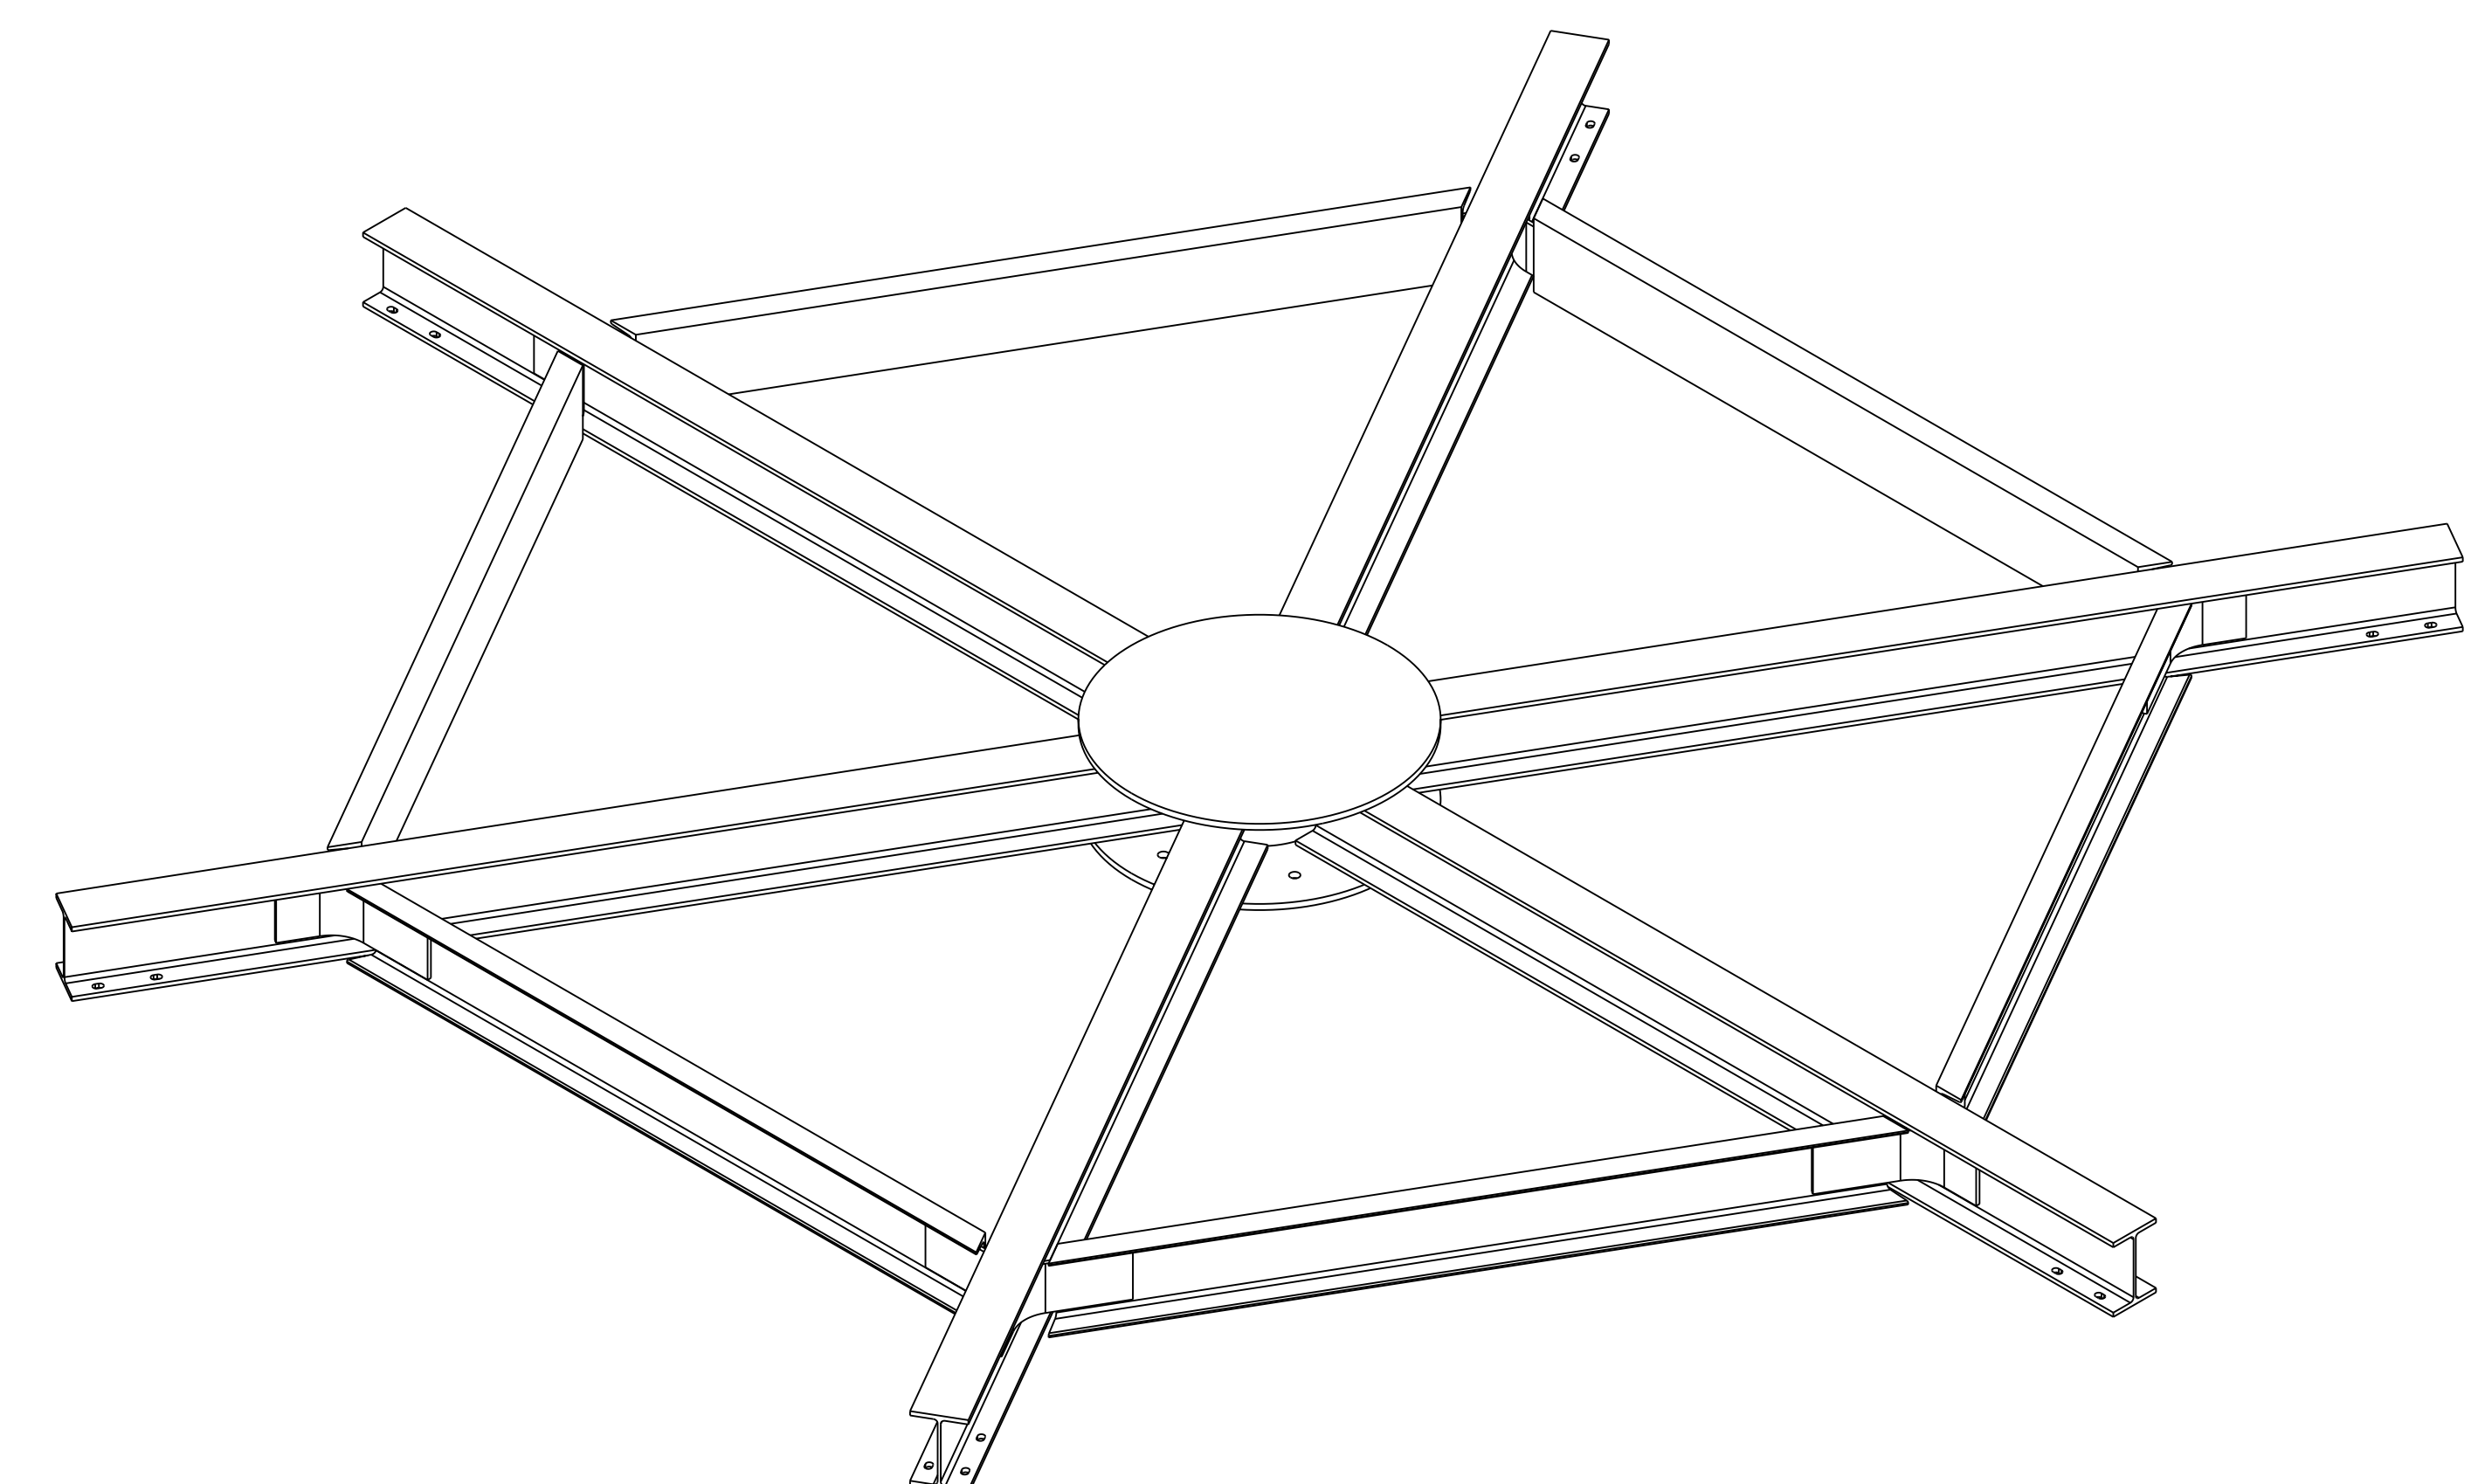



NO.	REVISION	BY	CH	SUP	APPROVED	DATE

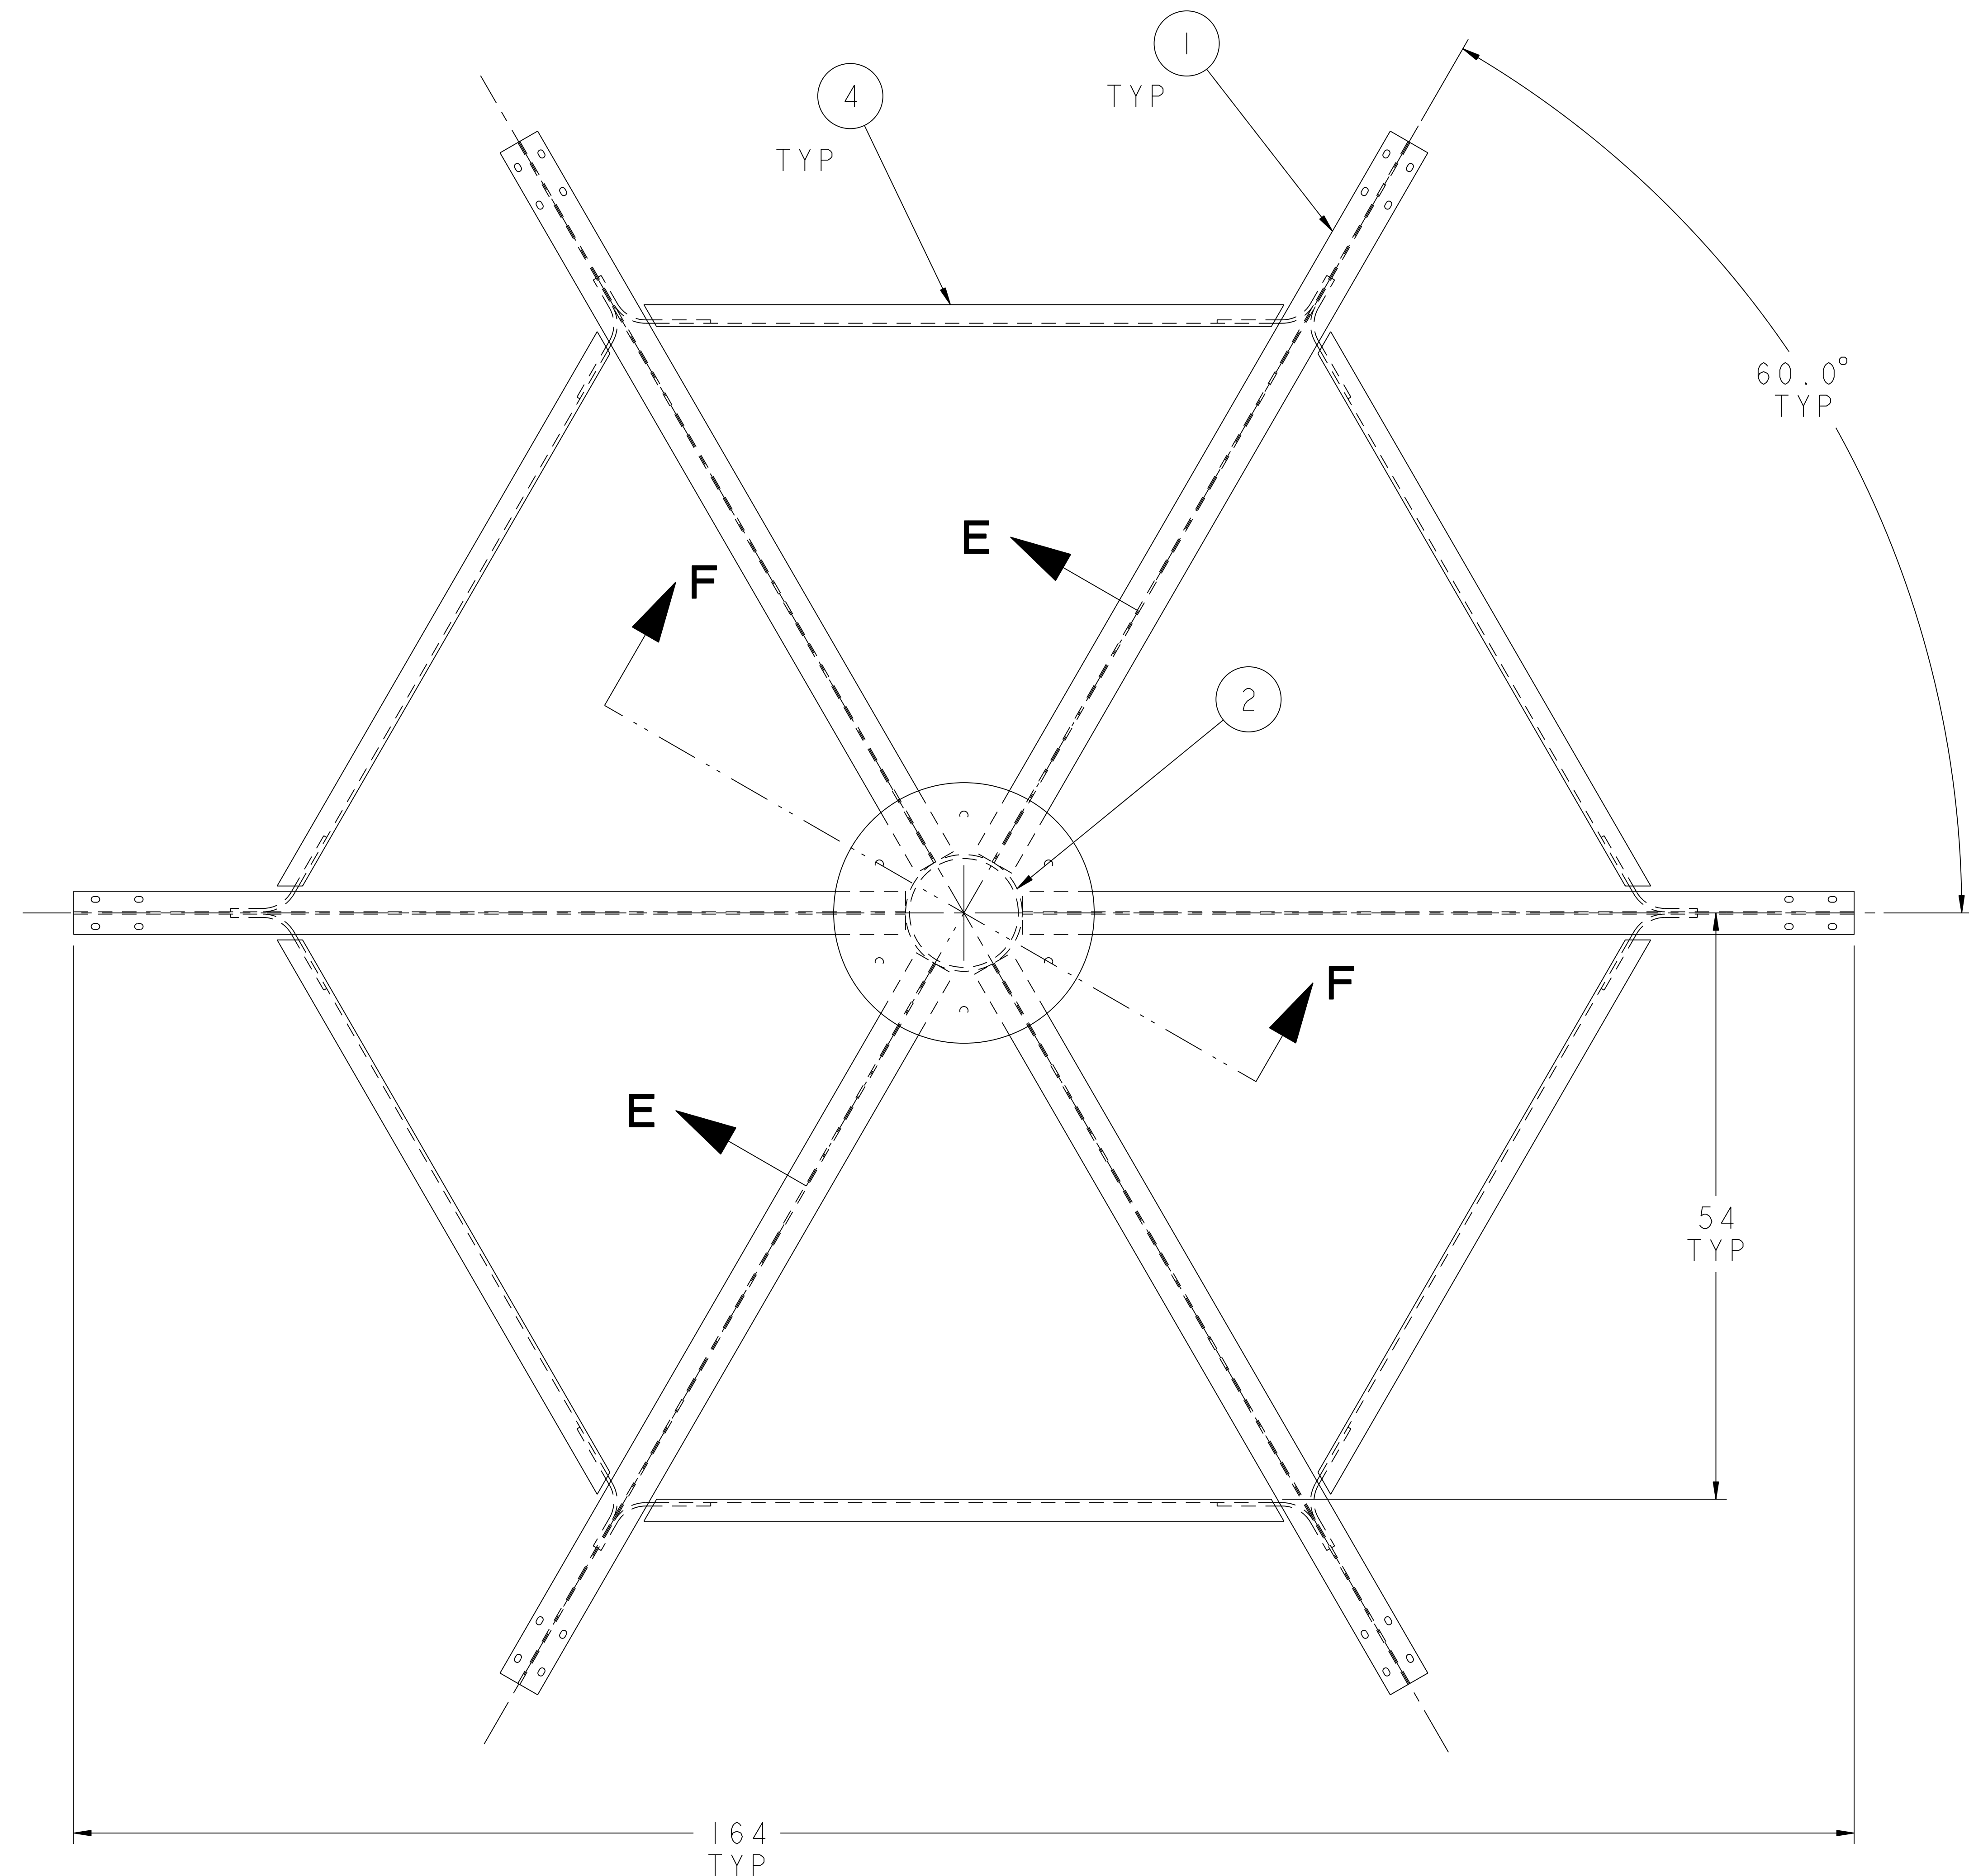

NOTE

WELDING SHALL BE PERFORMED IN ACCORDANCE WITH THE REQUIREMENTS OF AWS D1.2 (STRUCTURAL ALUMINUM WELDING) AND PPPL PROCEDURE EM-002. VISUAL WELD INSPECTION SHALL BE PERFORMED IN ACCORDANCE WITH THE ACCEPTANCE CRITERIA OF AWS D1.2.

NOTE ORIENTATION OF ALL PARTS BEFORE WELDING.

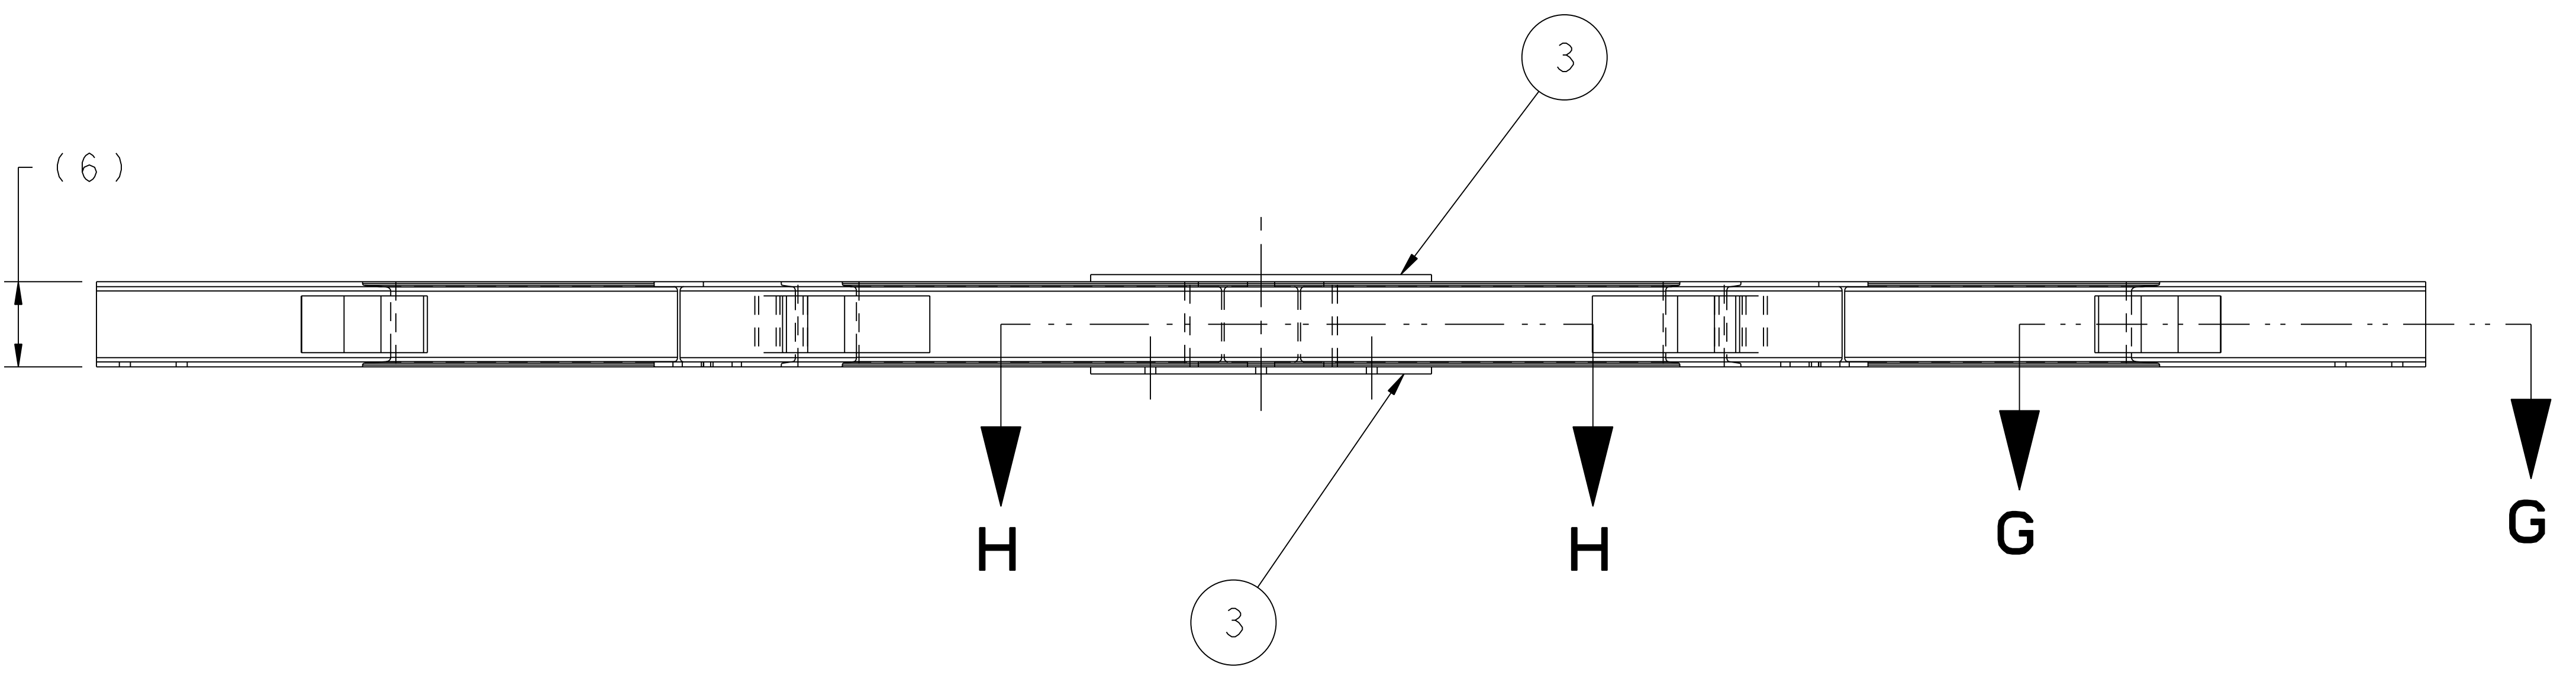

SEE SHEET #2 FOR ADDITIONAL INFORMATION

RELEASED FOR FABRICATION / INSTALLATION
PPPL Drafting:

PART NO.	DRAWING NO	NOMENCLATURE OR DESCRIPTION	MATERIAL	QTY RECD
4	SE144-381-4	CROSS BRACE	ALUM	6
3	SE144-381-3	BEAM TIE PLATE	ALUM	1
2	SE144-381-2	BEAM TIE RING	ALUM	1
1	SE144-381-1	SUPPORT BEAM	ALUM	6


COMPUTER GENERATED DRAWING		CENTRAL FILES:	PRINCETON PLASMA PHYSICS LABORATORY	
MANUAL CHANGES NOT PERMITTED	Pro E	UNLESS OTHERWISE SPECIFIED	NATIONAL COMPACT STELLARATOR EXPERIMENT	
DO NOT VERIFY INFORMATION BY SCALING DRAWING	SCALE 0.125	DIMENSIONS ARE IN INCHES MACHINE SURFACES	STELLARATOR CORE	
	NEXT ASSEMBLY	BREAK SHARP EDGES .005/.020	MODULAR COIL WINDING FACILITY	
		TOLERANCES NON-CUMULATIVE	COIL SUPPORT PLATFORM WELDING/ASSEMBLY	
		DECIMAL-INCH FRACTIONS	DSN: J. RUSHINSKI	DRAWING NO:
		.XX +/- .005	ENGR: S. RAFTOPOULOS	SE144-383
		ANGULAR +/- .05	SUPV:	SHEET 1 OF 2 REV 0

WEIGHT: 28135.2 lbs
MODEL NAME: SE144-383
RELEASE LEVEL: As Built
DWG VERSION NO: 0


NCSX-SE144-383

NCSX-PART-FORMAT.E


NO.	REVISION	BY	CH	SUP	APPROVED	DATE
1	REVISED PER ECN #4852	JDR	JC	JS	S. RAFTOPOULOS	5/05/04

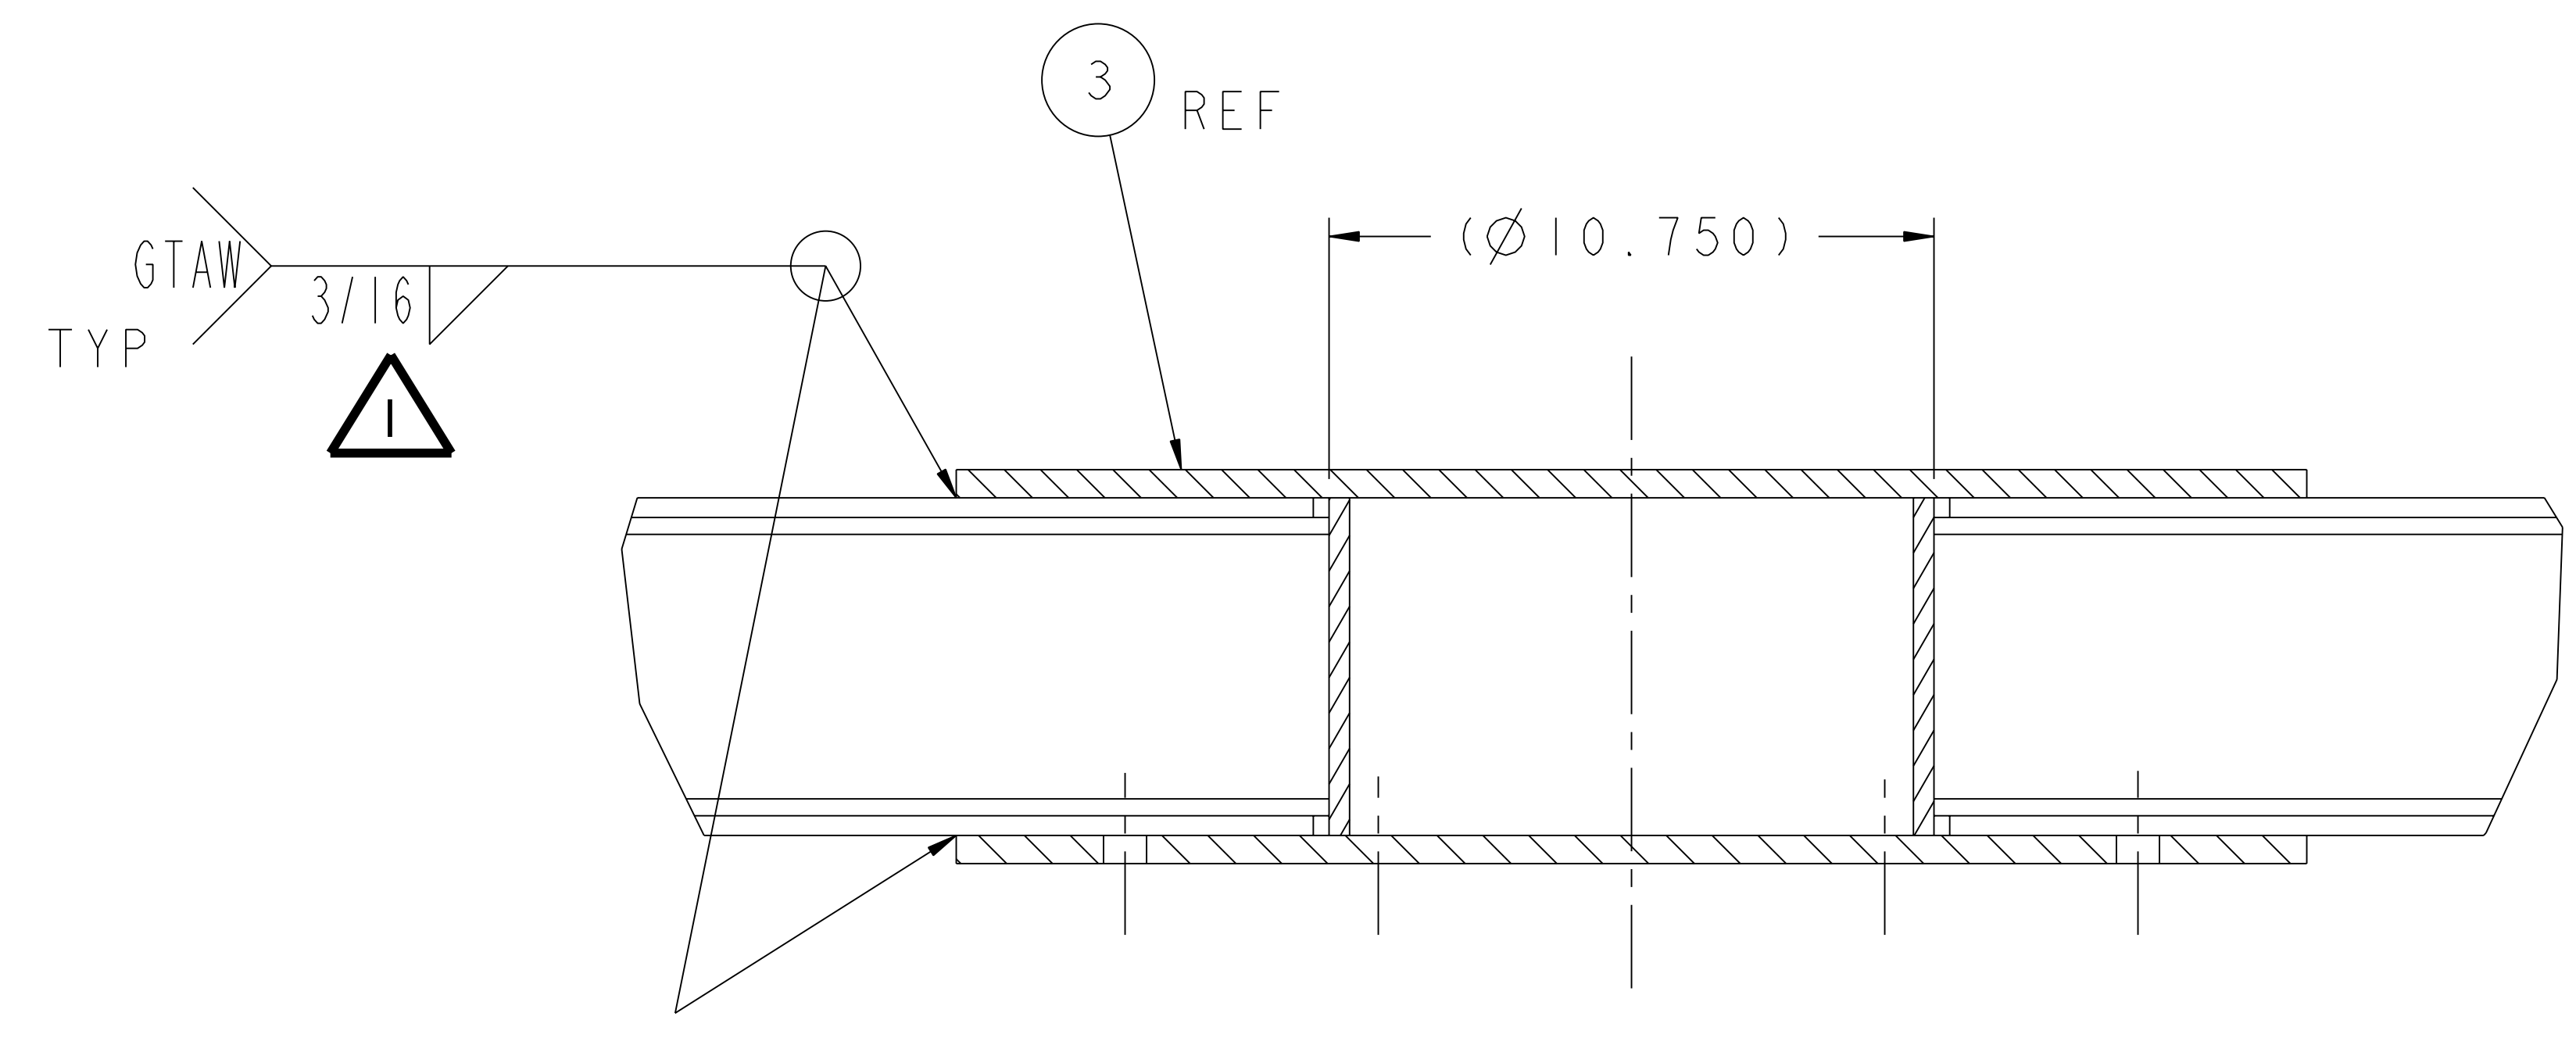


SECTION F-F
SCALE 0.375

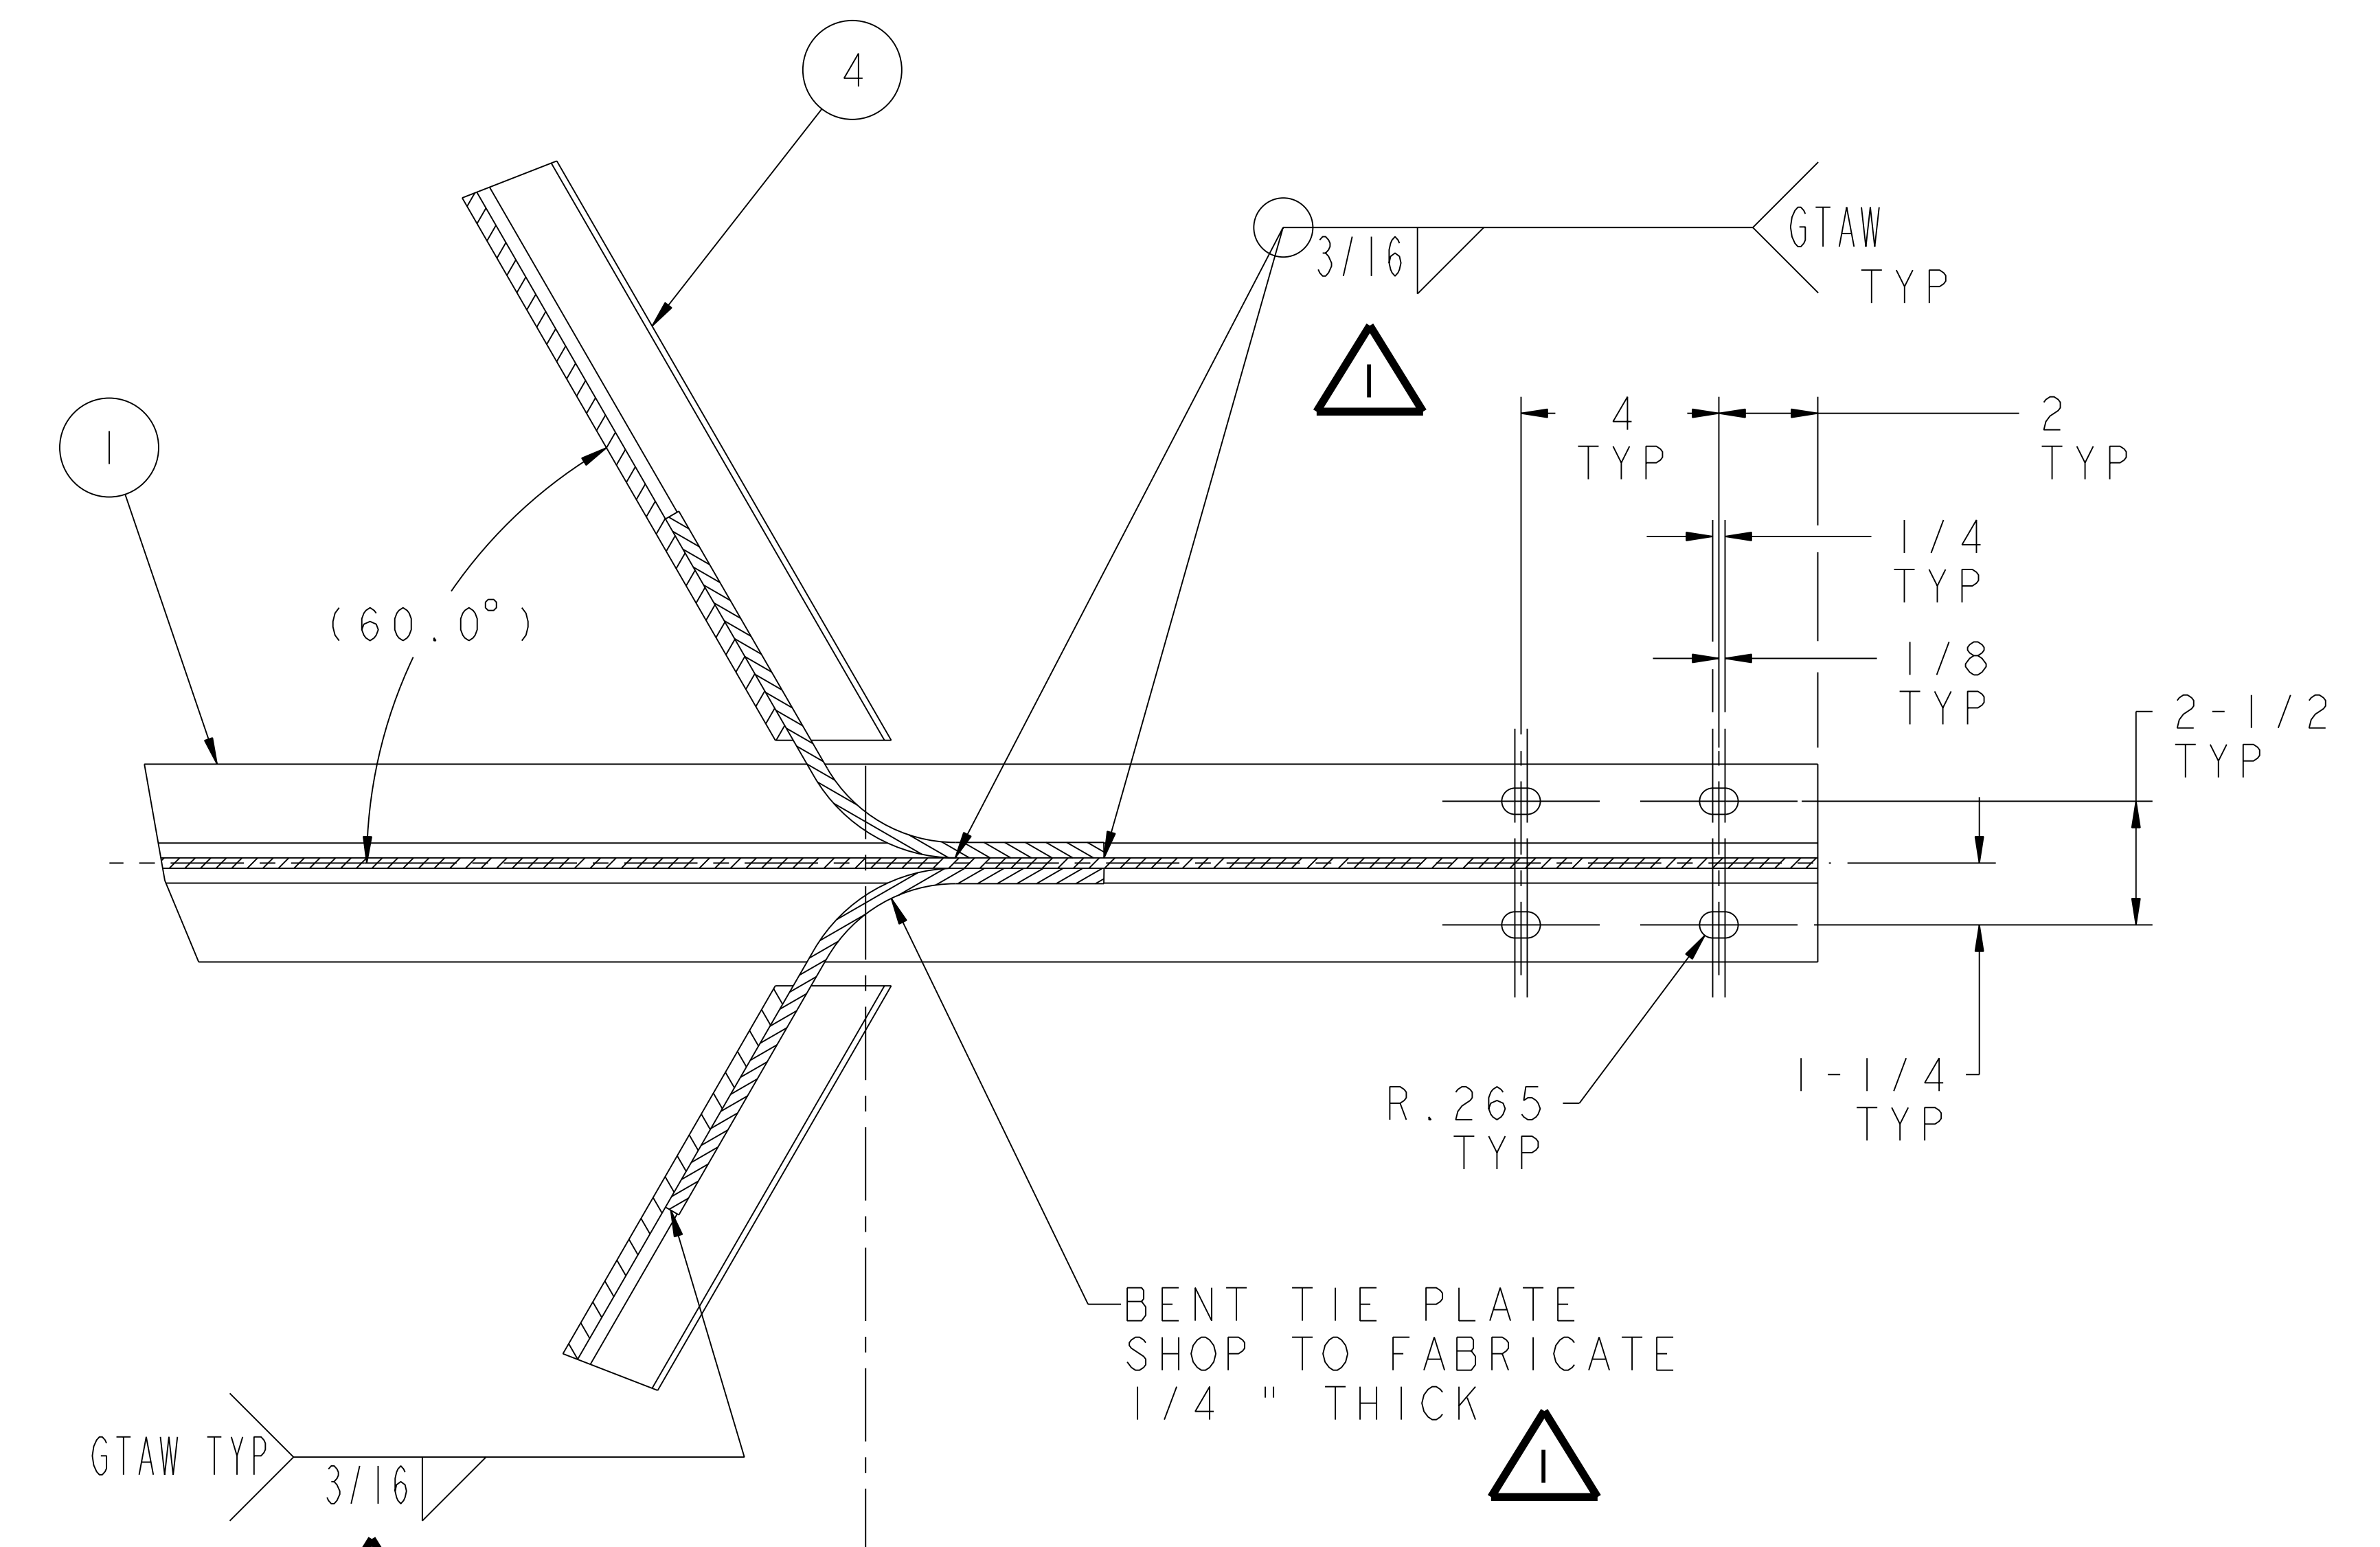

SECTION G-G
SCALE 0.375

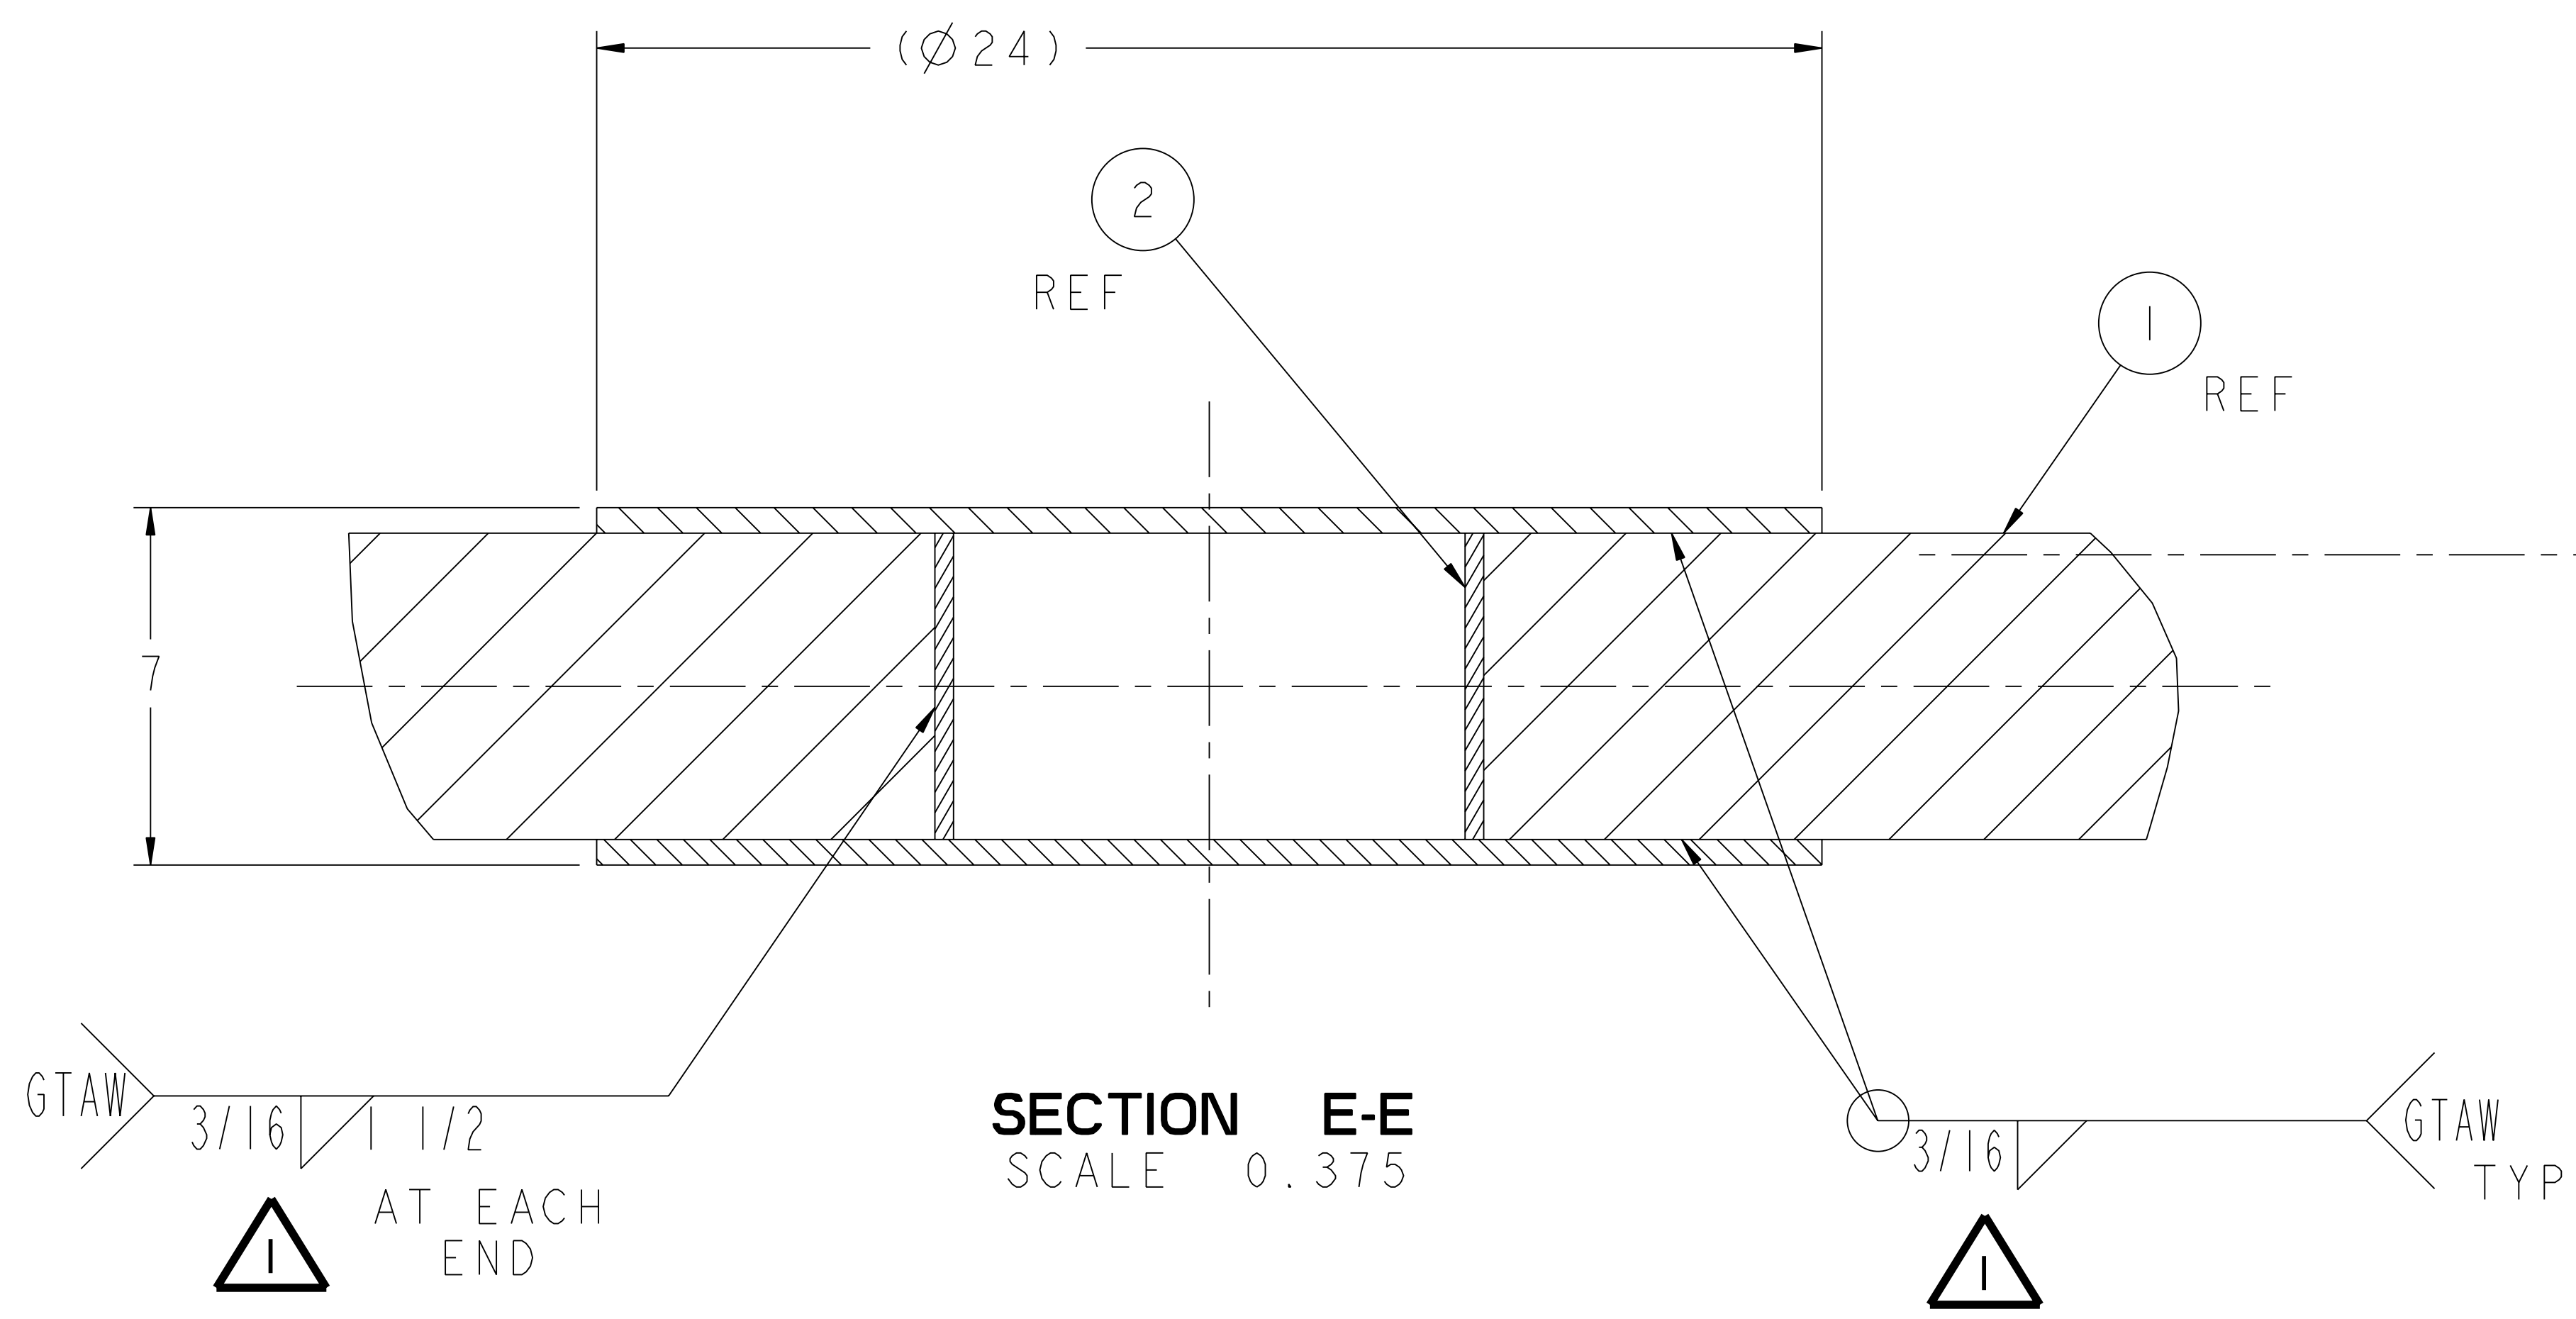

SECTION E-E
SCALE 0.375

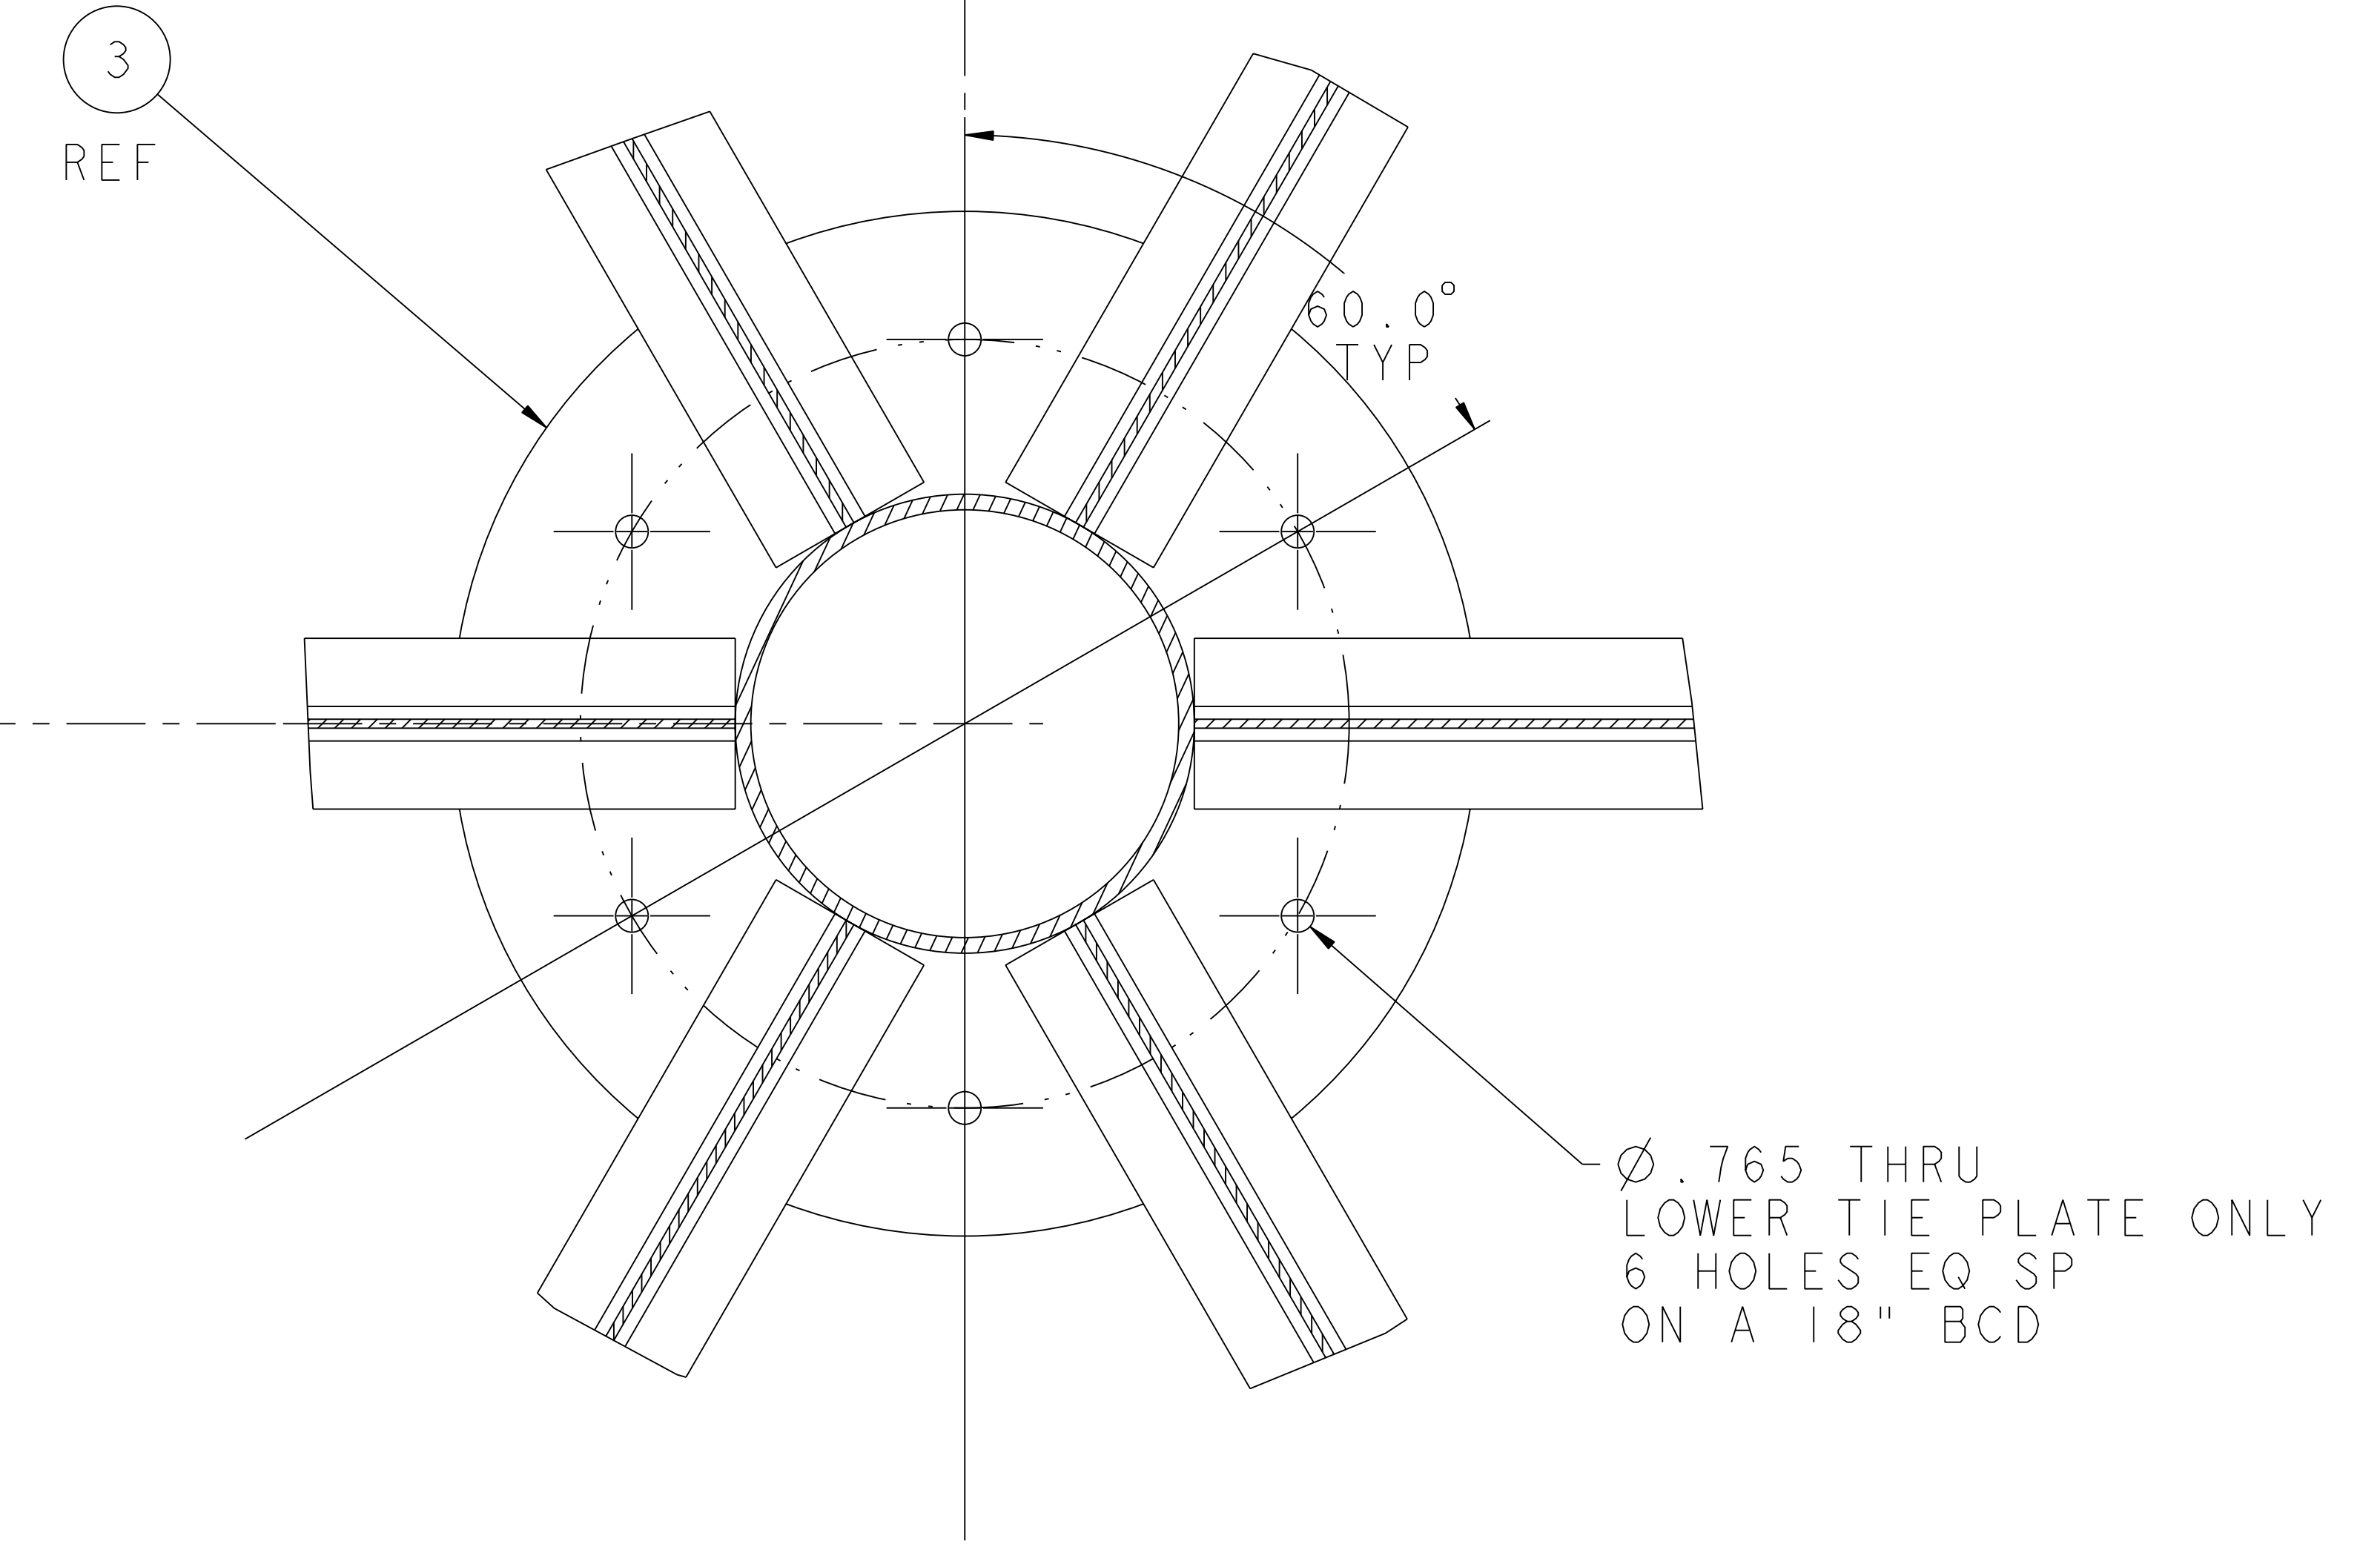

SECTION H-H
SCALE 0.300

FOR NOTES ANS B/M SEE SHEET #1

**RELEASED FOR
FABRICATION / INSTALLATION**

PPPL Drafting:

RELEASE LEVEL: As Built
DWG VERSION NO: 0

WEIGHT	28135.2 lbs
MODEL NAME	SE144-383
WELDING ENGINEER	

PART NO.	DRAWING NO	NOMENCLATURE OR DESCRIPTION	MATERIAL	QTY RECD
PARTS LIST				
COMPUTER GENERATED DRAWING MANUAL CHANGES NOT PERMITTED		CENTRAL FILES: UNLESS OTHERWISE SPECIFIED	PRINCETON PLASMA PHYSICS LABORATORY PRINCETON UNIVERSITY NATIONAL COMPACT STELLARATOR EXPERIMENT	
Pro E		DIMENSIONS ARE IN INCHES MACHINE SURFACES	STELLARATOR CORE MODULAR COIL WINDING FACILITY COIL SUPPORT PLATFORM WELDING DETAILS	
DO NOT VERIFY INFORMATION BY SCALING DRAWING		BREAK SHARP EDGES .005/0.020	DRAWING NO: SE144-383	
NEXT ASSEMBLY		TOLERANCES NON-CUMULATIVE	DSN: J. RUSHINSKI	
		DECIMAL-INCH FRACTIONS	CHK: J. CHRZANOWSKI	
		.XX ±.000 0°-12° ±.010	ENGR: S. RAFTOPOULOS	
		.XXX ±.005 12°-120° ±.010	SUPV: J. SIEGEL	
		ANGULAR ±.0°-15° OVER 120° ±.010		
			SHEET 2 OF 2	REV 1

NCSX-SE144-383