

NOTE

1. SEE SPECIFICATION NCSX-CSPEC-131-01-00 FOR ADDITIONAL INFORMATION AND/OR MATERIAL REQUIREMENTS
2. DIMENSIONS ARE IN INCHES.
3. Drawings prepared in accordance with ASME Y14.100-2000
4. Interpret Dimensions & tolerances per ASME Y14.5m-1994.

SE131-003-01 FOR RIGHT LEAD ORIENTATION
MADE FROM SE131-005-01

SE131-003-02 FOR LEFT LEAD ORIENTATION
MADE FROM SE131-005-02

I wasn't clear on sub drawing 005 would seem to be the right lead orientation only

ARE THESE TO BE USED FOR ASSEMBLY?

This is a Model Part a drawing?

131-03

SE131-003-01 DEPICTED



RELEASE LEVEL:
DWG VERSION NO:

PART NO	DRAWING NO	NOMENCLATURE OR DESCRIPTION	MATERIAL	QTY	REQD
6		EPOXY	EPOXY	CTD-101 K	AS BUB
5		GLASS	S2 GLASS	GLASS	AS BUB
4		ALIGNING COLLAR	BRASS		
3		BRASS LOCK W/ 400-8 IN DIA TUB/WELD FITTING	BRASS		
2		TF COIL WINDING CONDUCTOR (SE131-005-01/02) (RHS)	SW 303		
1		TF COIL ASSEMBLY (GROUNDWIPPER) (SE131-003-01 & SE131-003-02)	SEE DETAIL		

COMPUTER GENERATED DRAWING	MANUAL CHANGES NOT PERMITTED	ISSUE DATE: 1584 2 184	WEIGHT: 1584 2 184
SCALE: ASSEMBLY	SCALE: ASSEMBLY	MODEL NAME: SE131-003	MODEL NAME: SE131-003
PRINCETON PLASMA PHYSICS LABORATORY PRINCETON UNIVERSITY NATIONAL COMPACT STELLARATOR EXPERIMENT		STELLARATOR CORE CONVENTIONAL COILS TF COIL FINAL ASSEMBLY	
DESIGNED BY: DRK J. BUSH/RSK	CHECKED BY: DRK W. KALLIARIS/PAUL	DATE: 2/11/98	DRAWN BY: DRK W. KALLIARIS/PAUL
DATE: 2/11/98	DATE: 2/11/98	DATE: 2/11/98	DATE: 2/11/98
SUPV: J. BIERER	DATE: 2/11/98	SHEET: 1 OF 5	REV: 0


2432156

NO.	REVISION	BY	CH	SUP	APPROVED	DATE

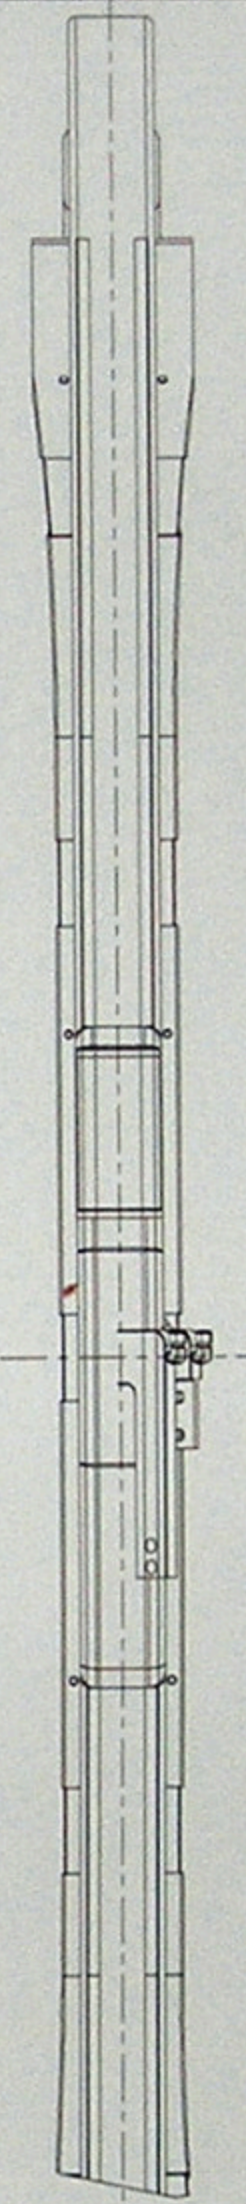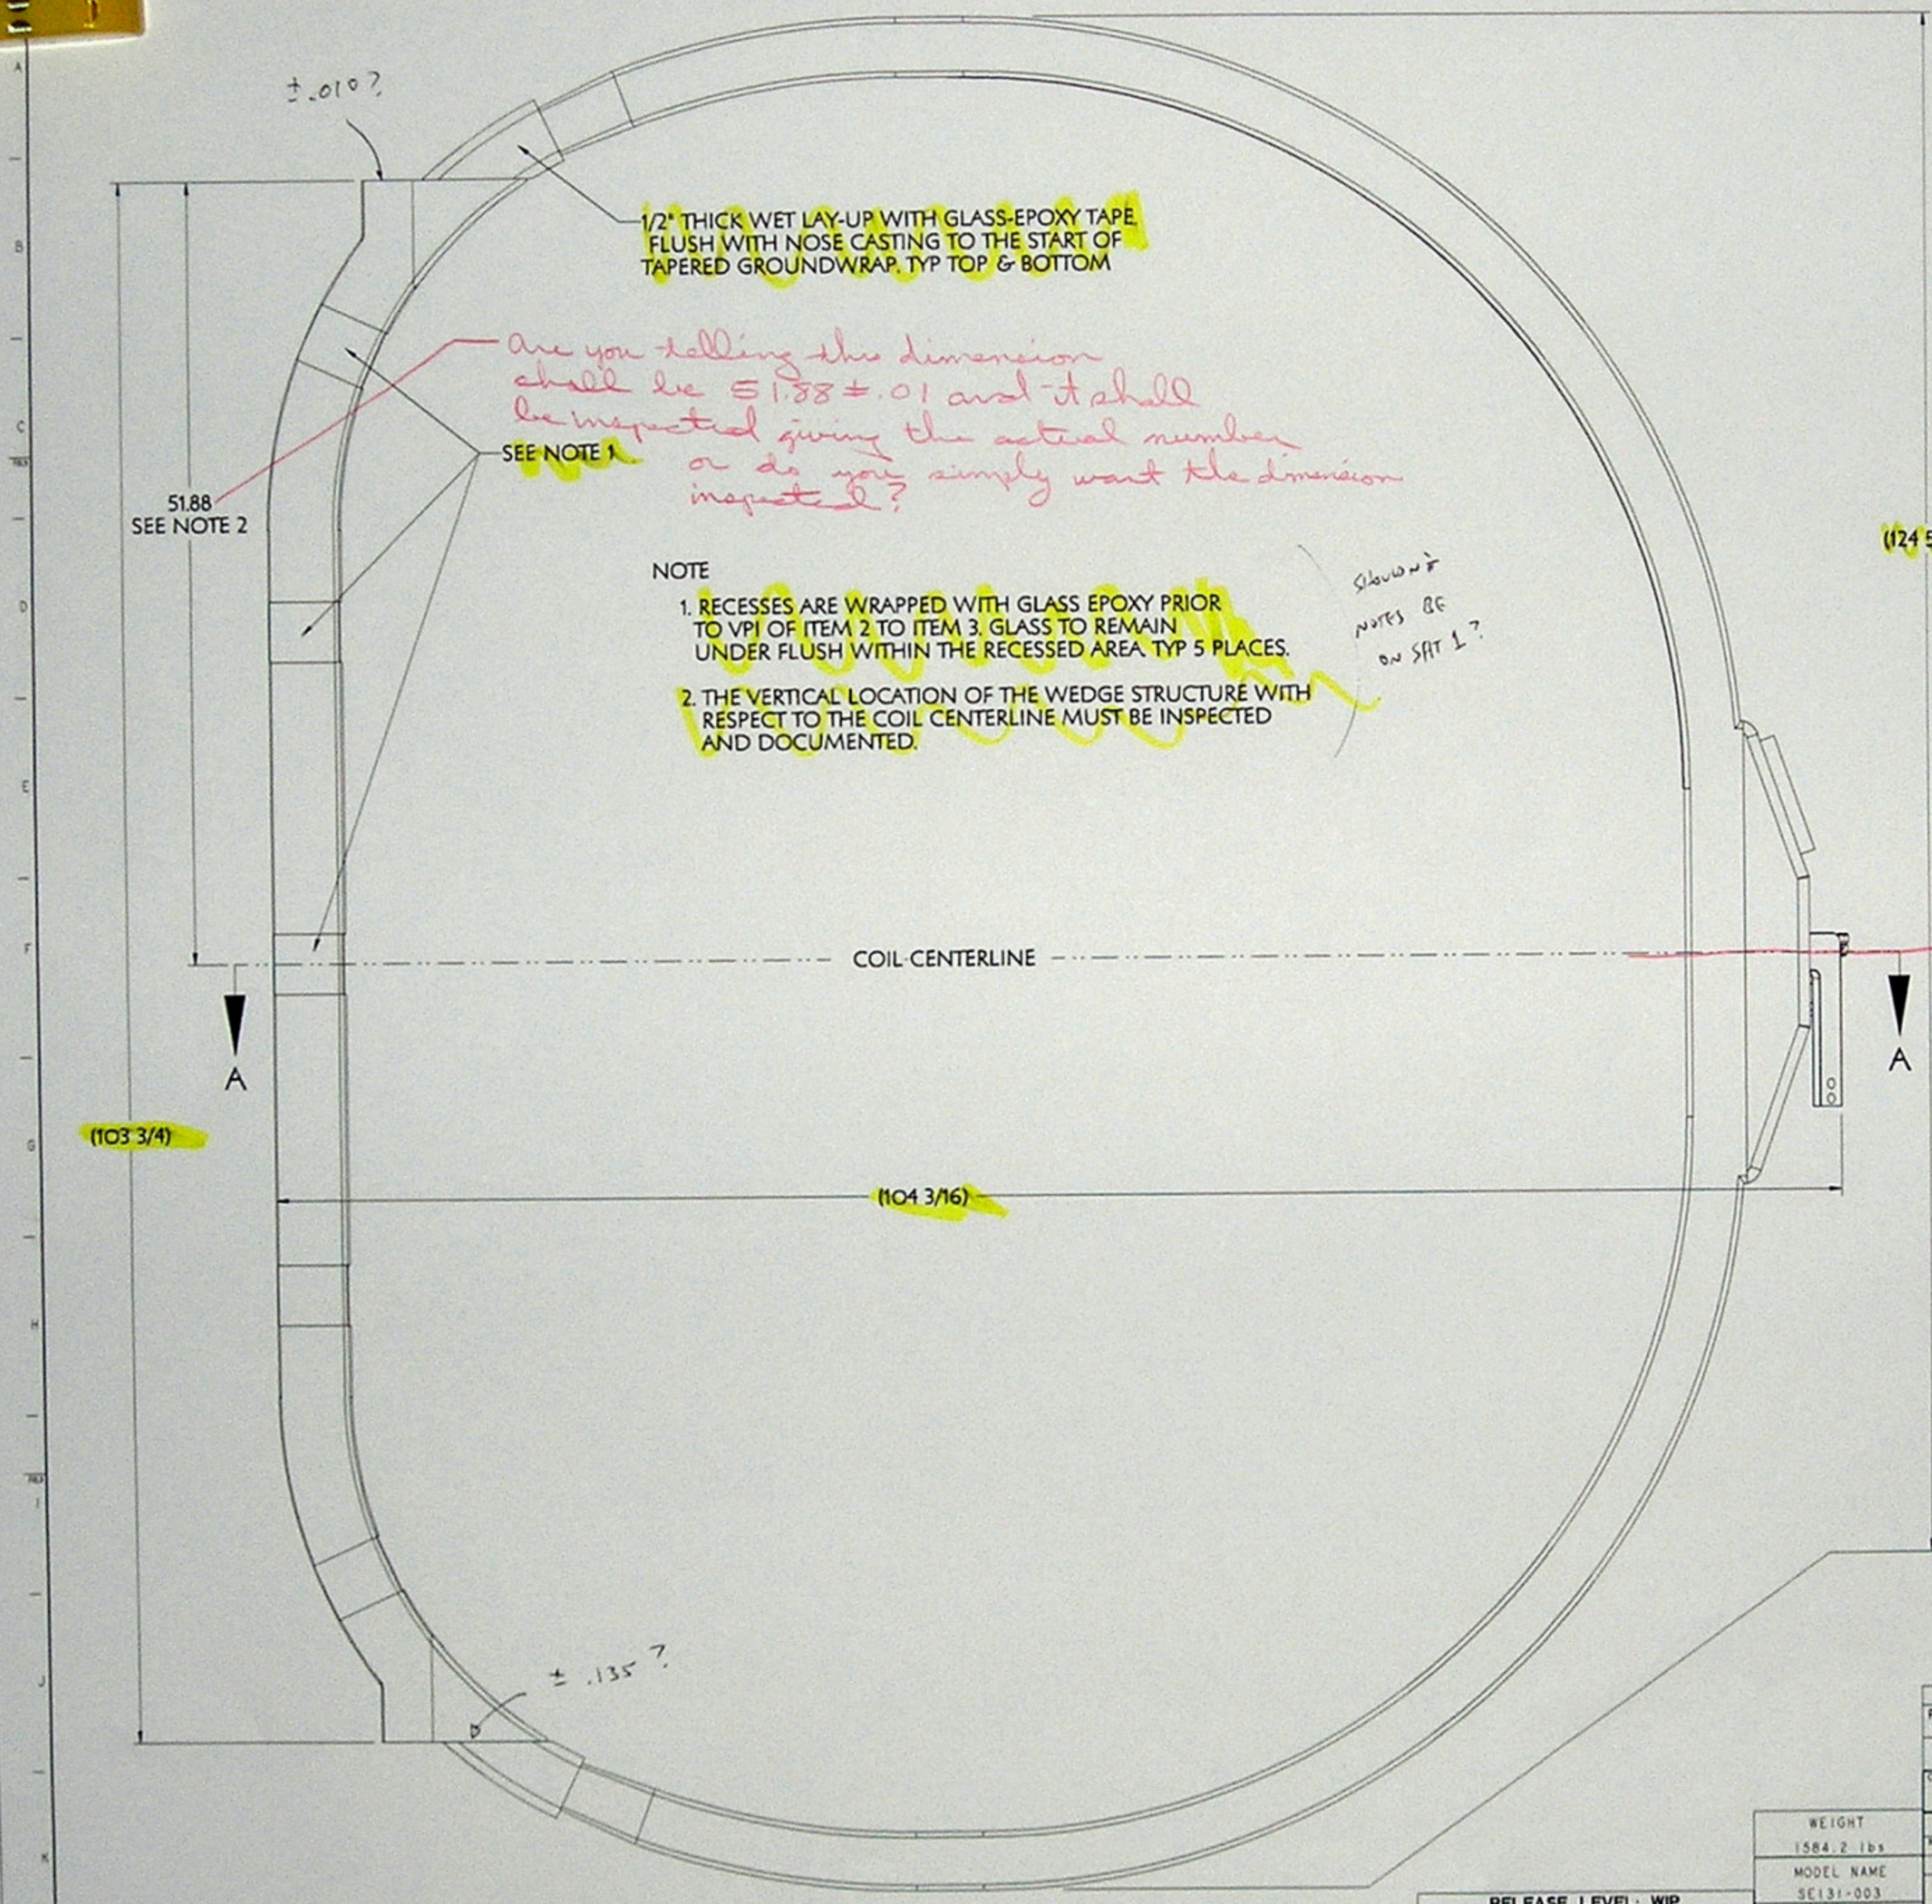


PART NO.	DRAWING NO.	NOMENCLATURE OR DESCRIPTION	MATERIAL	QTY	REQD
PARTS LIST					
COMPUTER GENERATED DRAWING MANUAL CHANGES NOT PERMITTED PFA 6					
CENTRAL FILES: UNLESS OTHERWISE SPECIFIED DIMENSIONS ARE IN INCHES UNLESS OTHERWISE SPECIFIED BREAK SHARP EDGES UNLESS NOTED					
PRINCETON PLASMA PHYSICS LABORATORY PRINCETON UNIVERSITY NATIONAL COMPACT STELLARATOR EXPERIMENT STELLARATOR CORE CONVENTIONAL COILS TF COIL FINAL ASSEMBLY					
WEIGHT		TOLERANCES: NON-CUMULATIVE		DRAWING NO:	
1584.2 lbs		DECIMALS FRACTIONS		SEI31-003	
MODEL NAME		NEXT ASSEMBLY		DATE	
SEI31-003		SEE DRAWING		2/1/78	
RELEASE LEVEL: WIP		DWG VERSION NO. 4		SHEET 2 OF 5	
DESIGNED BY: J. SIEBEL		CHECKED BY: W. KALLIBS PAUL		DATE: 2/1/78	
DRAWN BY: J. SIEBEL		APPROVED BY: EMMER W. KALLIBS		DATE: 2/1/78	
DATE: 2/1/78		DATE: 2/1/78		DATE: 2/1/78	
DATE: 2/1/78		DATE: 2/1/78		DATE: 2/1/78	

NCSX-SEI31-003

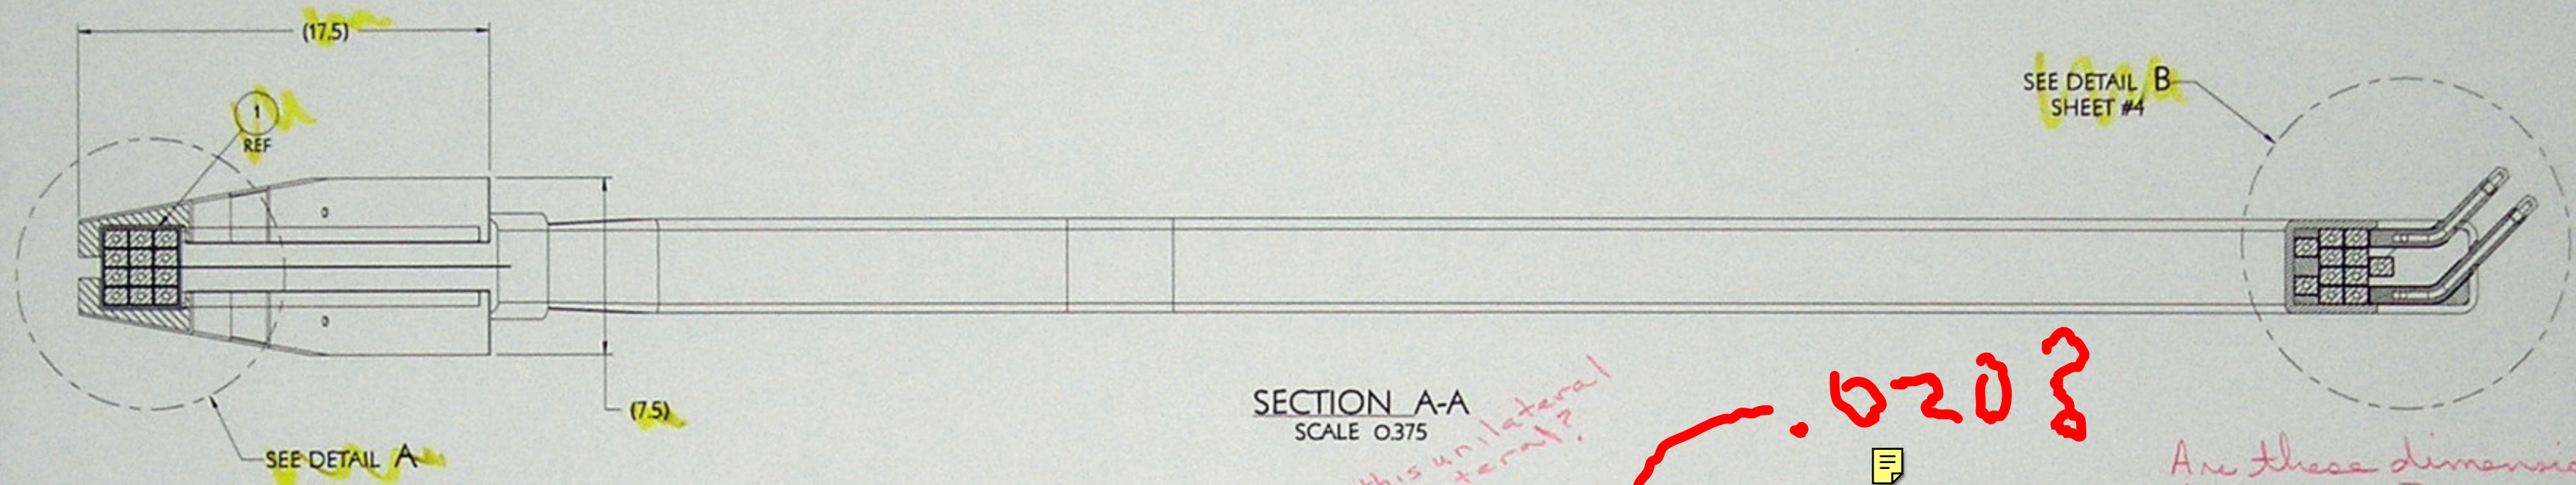

SECTION A-A
SCALE 0.375

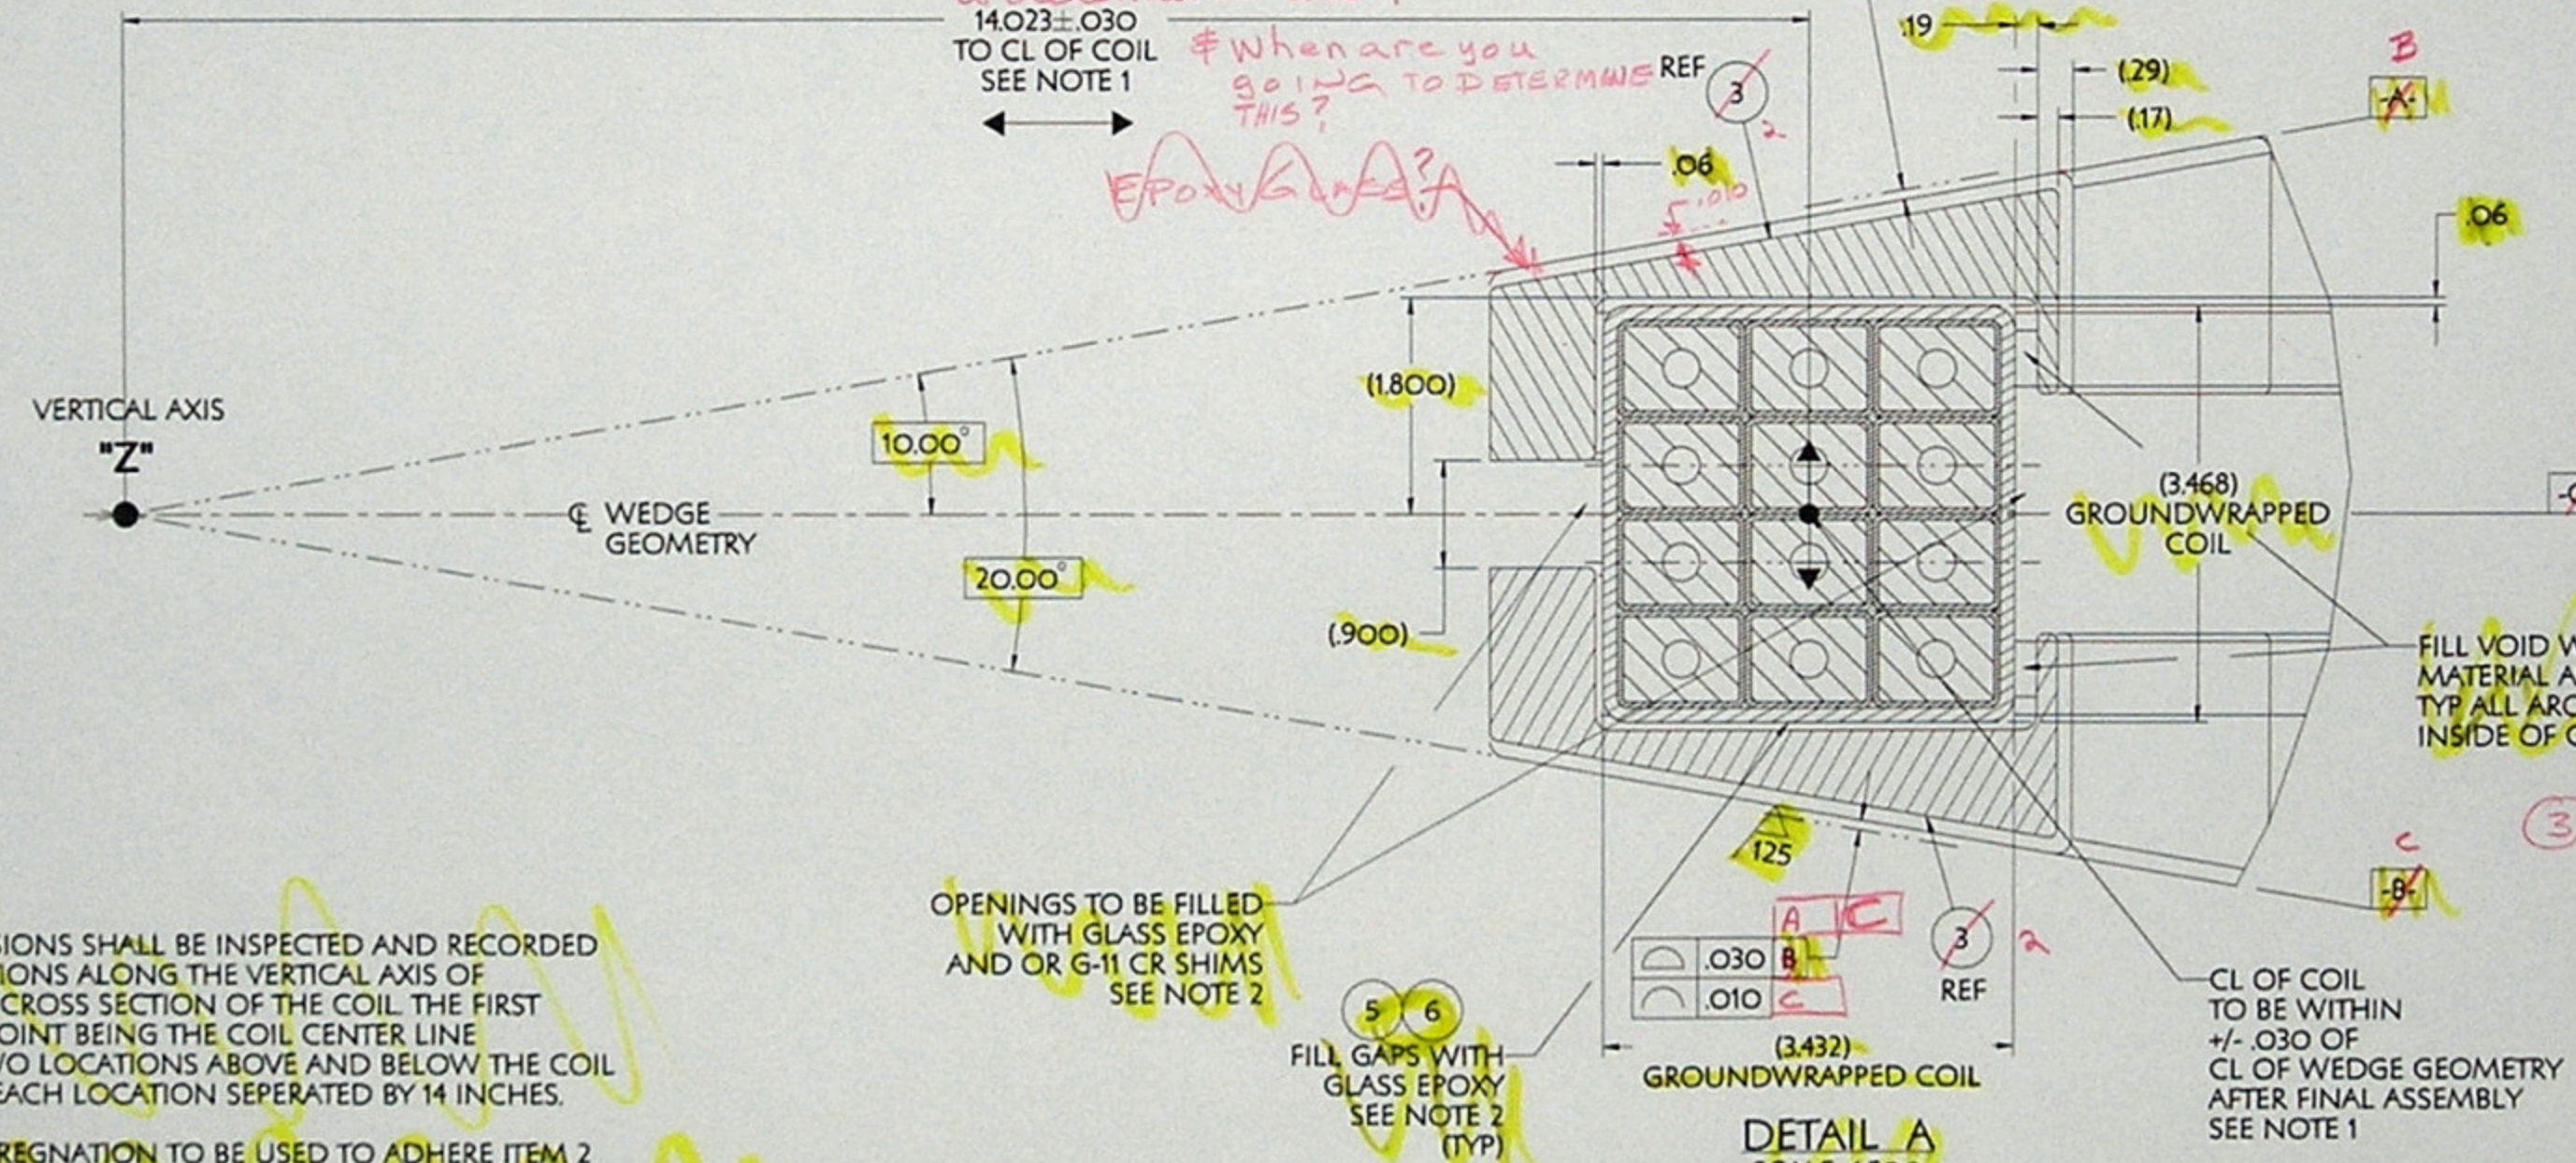


NOTE

1. THESE DIMENSIONS SHALL BE INSPECTED AND RECORDED AT FIVE LOCATIONS ALONG THE VERTICAL AXIS OF THE WEDGED CROSS SECTION OF THE COIL THE FIRST INSPECTION POINT BEING THE COIL CENTER LINE AND THEN TWO LOCATIONS ABOVE AND BELOW THE COIL CENTER LINE EACH LOCATION SEPERATED BY 14 INCHES.
2. VACUUM IMPREGNATION TO BE USED TO ADHERE ITEM 2 TO ITEM 3. ALL VOIDS TO BE FILLED WITH S2 GLASS INSULATION TO ELIMINATE RESIN RICH AREAS. GLASS THICKNESS INSIDE WEDGE STRUCTURE TO BE ADJUSTED TO ACHIEVE REQUIRED DIMENSIONS WITHIN TOLERANCE.
3. ITEM 3 WEDGE STRUCTURE AND COIL SURFACE TO BE ROUGHENED BEFORE VPI TO ENSURE BEST POSSIBLE ADHESION.
4. POCKETS IN ITEM 3 ON MATING SURFACES TO BE FILLED WITH GLASS TAPE PRIOR TO VPI.

RELEASE LEVEL: WIP
DWG VERSION NO: 4

WEIGHT
1584.2 lbs
MODEL NAME
SEI31-003

PART NO.	DRAWING NO.	NOMENCLATURE OR DESCRIPTION	MATERIAL	QTY REQD
PARTS LIST				
COMPUTER GENERATED DRAWING MANUAL CHANGES NOT PERMITTED	CENTRAL FILED UNLESS OTHERWISE SPECIFIED	PRINCETON PLASMA PHYSICS LABORATORY PRINCETON UNIVERSITY NATIONAL COMPACT STELLARATOR EXPERIMENT		
P14 E DO NOT SCALE DIMENSIONS BY DIM. OR DIM. P14	STRENGTHS ARE IN INCHES MACHINE SURFACES BREAK SHARP EDGES R20.000	STELLARATOR CORE CONVENTIONAL COILS TF COIL FINAL ASSEMBLY		
TOLERANCES UNLESS OTHERWISE SPECIFIED	FRACTIONS	DRW: J. RUSHINKI ENGR: W. KALISHA SUPP: J. BIEDEL	2/21/94 2/21/94 2/21/94	DRAWING NO: SEI31-003 SHEET 3 OF 5

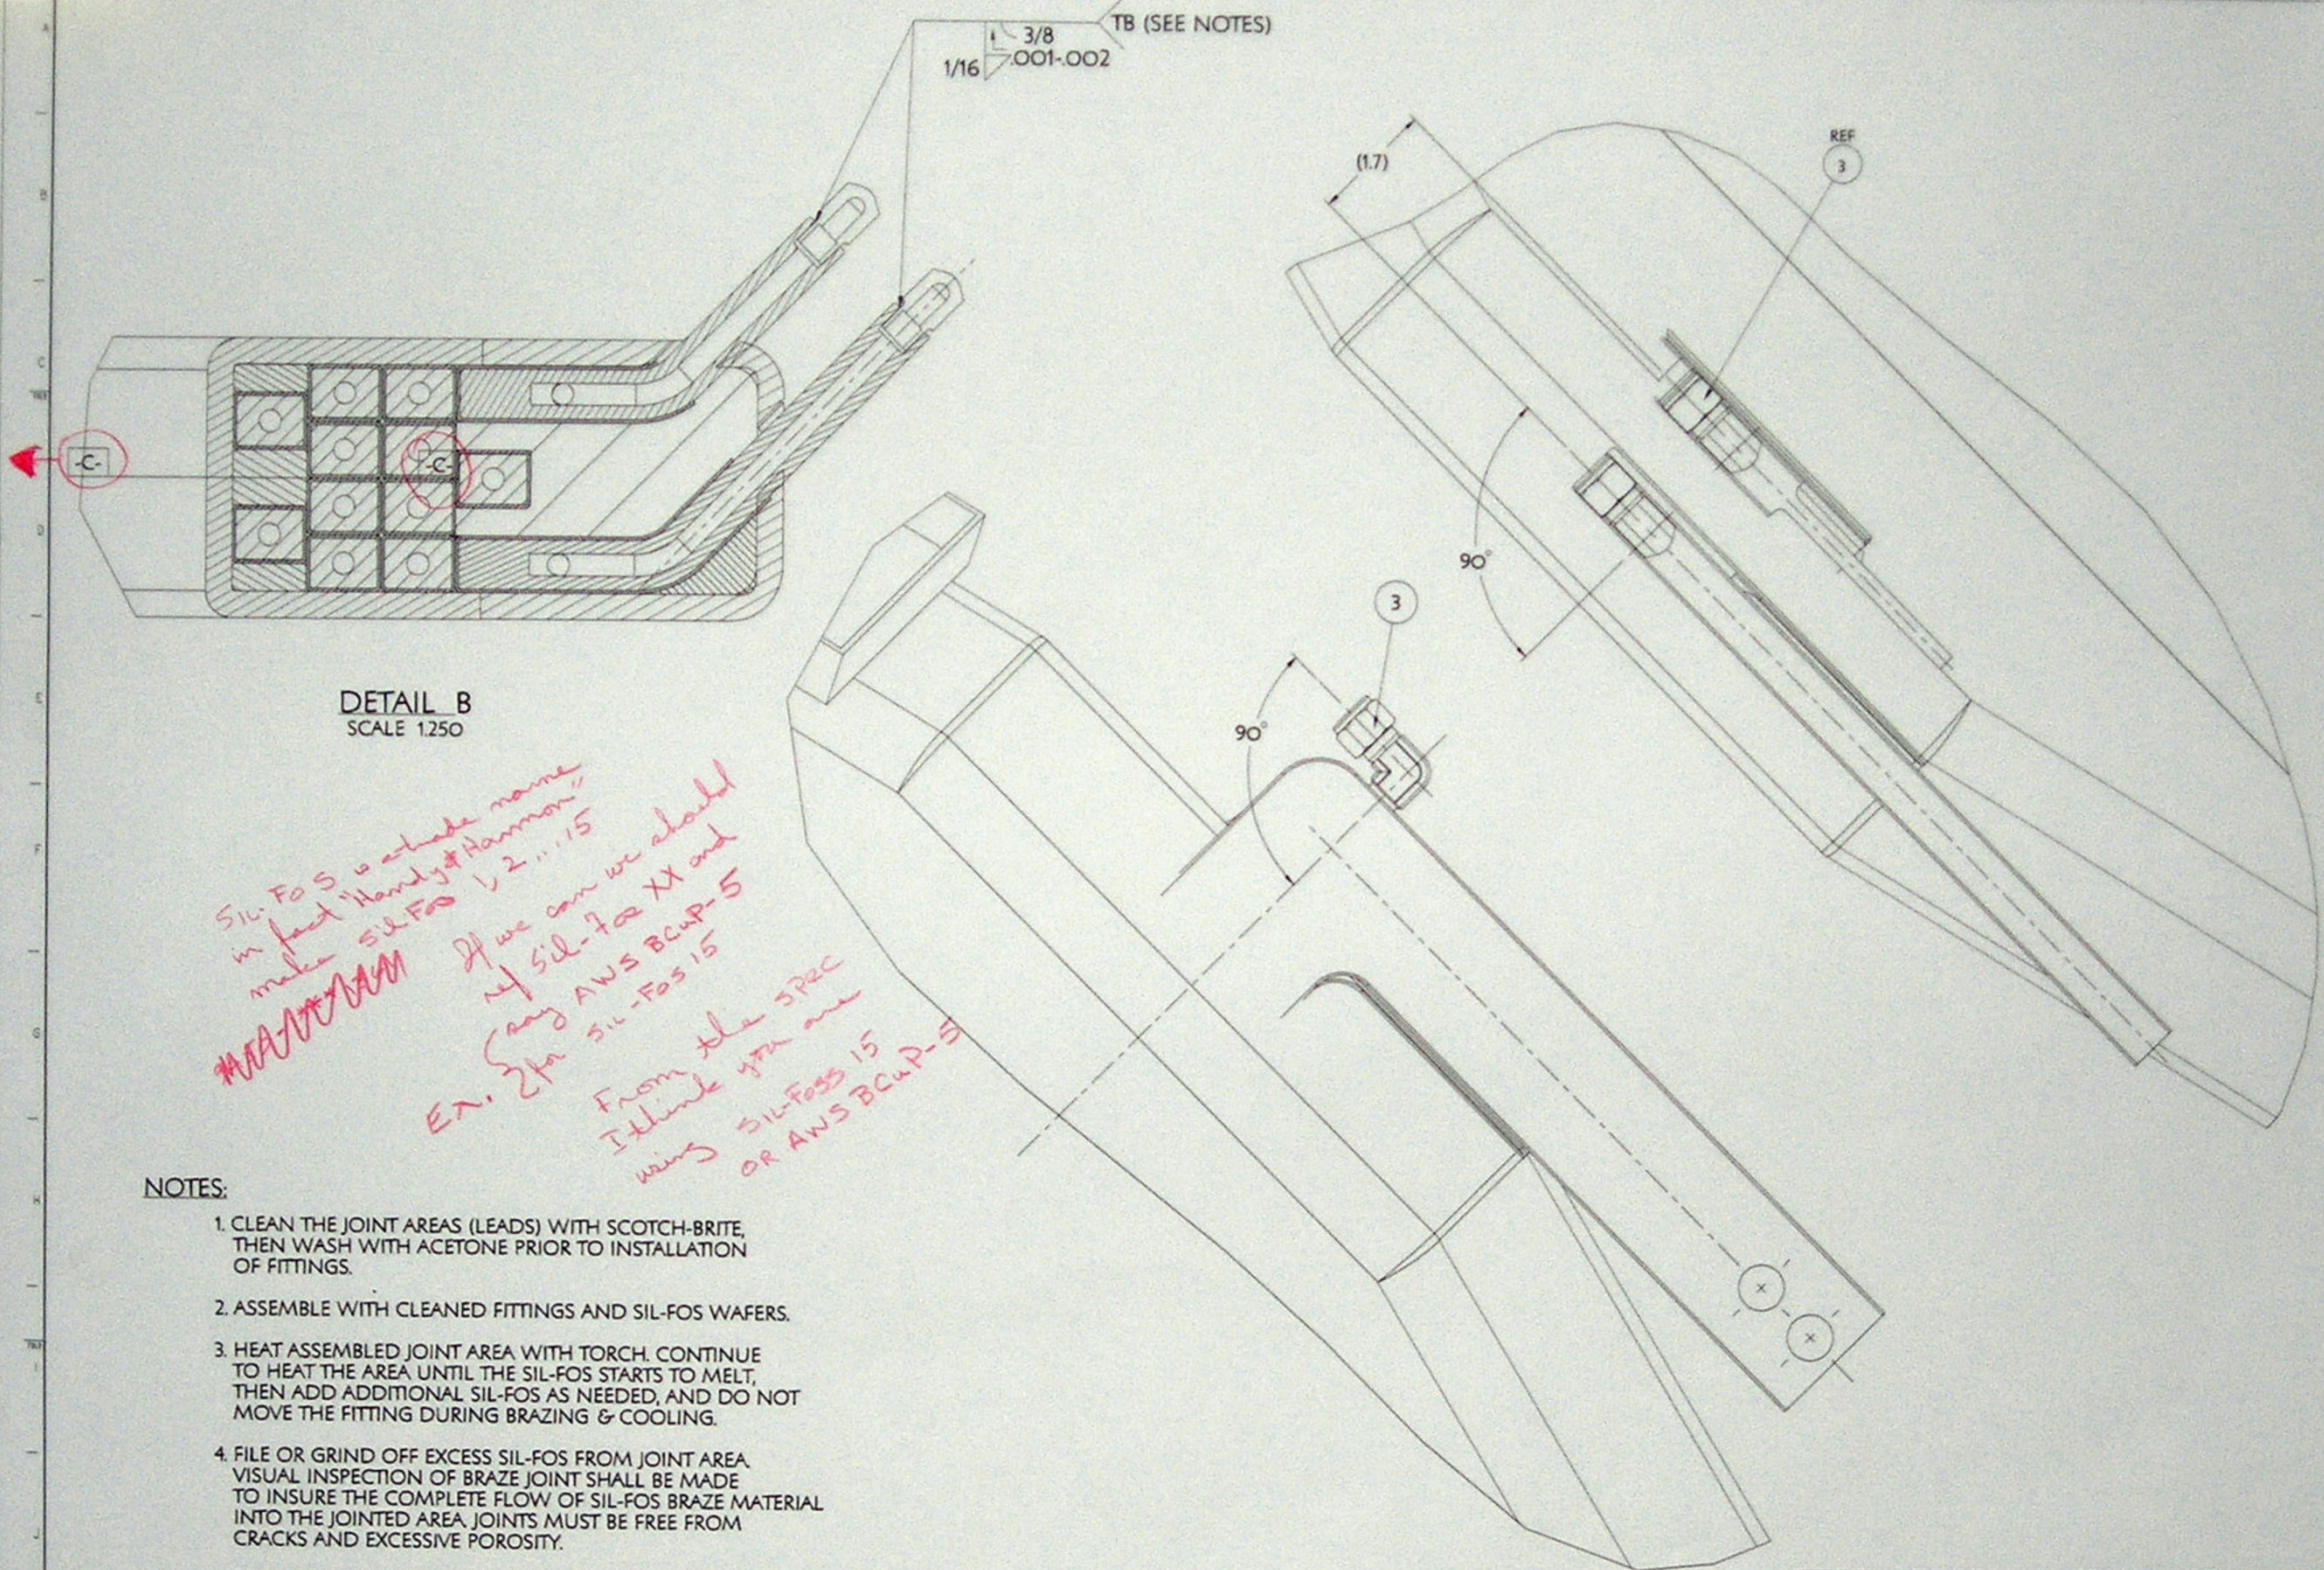

SIL-FOS is etched name in fact "Hardy & Harmon" make SIL-FOS 1, 2, ..., 15

AAADAM If we can we should use SIL-FOS XX and AWS BCuP-5

EX. 2 for SIL-FOS 15

From the spec I think you are using SIL-FOS 15 OR AWS BCuP-5

NOTES:

1. CLEAN THE JOINT AREAS (LEADS) WITH SCOTCH-BRITE, THEN WASH WITH ACETONE PRIOR TO INSTALLATION OF FITTINGS.
2. ASSEMBLE WITH CLEANED FITTINGS AND SIL-FOS WAFERS.
3. HEAT ASSEMBLED JOINT AREA WITH TORCH. CONTINUE TO HEAT THE AREA UNTIL THE SIL-FOS STARTS TO MELT, THEN ADD ADDITIONAL SIL-FOS AS NEEDED, AND DO NOT MOVE THE FITTING DURING BRAZING & COOLING.
4. FILE OR GRIND OFF EXCESS SIL-FOS FROM JOINT AREA. VISUAL INSPECTION OF BRAZE JOINT SHALL BE MADE TO INSURE THE COMPLETE FLOW OF SIL-FOS BRAZE MATERIAL INTO THE JOINTED AREA. JOINTS MUST BE FREE FROM CRACKS AND EXCESSIVE POROSITY.
5. PROTECT TURN AND GROUNDWRAP INSULATION FROM DAMAGE DURING ALL TORCH BRAZING OPERATIONS
6. SEE SPECIFICATION FOR QUALIFICATION AND TESTING REQUIREMENTS OF ALL BRAZE JOINTS.
7. FITTING (PART #4) TO BE BRAZED TO LEAD PRIOR TO GROUNDWRAP AND VPI.

RELEASE LEVEL: WIP
DWG VERSION NO: 4

PART NO.	DRAWING NO.	NOMENCLATURE OR DESCRIPTION	MATERIAL	QTY	REQD
PARTS LIST					
COMPUTER GENERATED DRAWING		PRINCETON PLASMA PHYSICS LABORATORY			
MANUAL CHANGES NOT PERMITTED		PRINCETON UNIVERSITY			
UNLESS OTHERWISE SPECIFIED		NATIONAL COMPACT STELLARATOR EXPERIMENT			
DIMENSIONS ARE IN INCHES		STELLARATOR CORE			
MACHINE SURFACES UNLESS OTHERWISE SPECIFIED		CONVENTIONAL COILS			
TOLERANCES NON-CUMULATIVE		TF COIL FINAL ASSEMBLY			
DRAWING NO.		DESIGNER	DATE	DRAWING NO.	
NEXT ASSEMBLY		CHK'D	DATE	DRAWING NO.	
DRAWING NO.		ENGR	DATE	DRAWING NO.	
DRAWING NO.		SUPPLY	DATE	DRAWING NO.	
DRAWING NO.		SHEET 4 OF 5		REV 0	

NCSX-SEI31-003

NOTE

1. TOLERANCES FOR THE NOMINAL POSITION OF THE CURRENT CENTROID WITH RESPECT TO VERTICAL AXIS "Z" ARE AS FOLLOWS:
 - a. FOR THE STRAIGHT LEG UNDER THE WEDGE STRUCTURE IT IS DEFINED IN DETAIL "A" ON SHEET 3.
 - b. FOR THE FRONT HALF OF THE COIL EXCLUSIVE OF THE STRAIGHT LEG OF THE WEDGE STRUCTURE +/- .060 INCHES.
 - c. FOR THE IN PLANE TOLERANCE ON THE BACK HALF (LEAD END) OF THE COIL +/- .12 INCHES.
 - d. FOR THE OUT OF PLANE BACK HALF (LEAD END) OF THE COIL +/- .06 INCHES.

TOLERANCES INDICATED FOR THE COIL IN THE UN-RESTRAINED CONDITION.
with the coil standing up compressed or laying down horizontal? Before VP1 or After?

VERTICAL AXIS "Z"

(14.023±.030)
SEE NOTE 1a

53.443

I don't think you can specify both the radius & horizontal dim once you have called out 14.023 dim. One of them has to be a ref dim!

107.231±.120
SEE NOTE 1c & 1d

7.163
REF.

10.872

28.785

43.047

4.482

R49.306±.120
SEE NOTE 1c & 1d
TYP

This one is okay because it does not go back to the 0

R29.024±.060
SEE NOTE 1b
TYP

R53.015±.060
SEE NOTE 1b
TYP

PART NO.	DRAWING NO.	NOMENCLATURE OR DESCRIPTION	MATERIAL	QTY	RECD
PARTS LIST					
COMPUTER GENERATED DRAWING MANUAL CHANGES NOT PERMITTED	CENTRAL FILES: UNLESS OTHERWISE SPECIFIED	PRINCETON PLASMA PHYSICS LABORATORY PRINCETON UNIVERSITY			
FR 6	DIMENSIONS ARE IN INCHES MACHINE SURFACES	NATIONAL COMPACT STELLARATOR EXPERIMENT			
SEE NOTE 1 FOR DIMENSIONS BY MACHINE SURFACES	BREAK SHARP EDGES .005 R	STELLARATOR CORE CONVENTIONAL COILS TF COIL FINAL ASSEMBLY			
WEIGHT 1584.2 lbs	TOLERANCES: NON-CUMULATIVE	DRN: J. RUSH/NSK	Z/D: J/SB	DRAWING NO: SE131-003	
MODEL NAME SE131-003	WELDING ENGINEER	CHK: W. KALISH	Z/D: J/SB	SHEET 5 OF 5	
		ENGR: W. KALISH	Z/D: J/SB	REV: 0	
		SUPP: J. STEBEL	Z/D: J/SB		

RELEASE LEVEL: WIP
DWG VERSION NO: 4

NCSX-SE131-003

NO.	REVISION	BY	CR	SUP	APPROVED	DATE


5 1/2
TAPER GROUNDWRAP
FROM 1/8" TO 3/8" THICK
OVER THIS LENGTH
AT THIS LOCATION
TYP TOP & BOTTOM

NOTE
ALL DIMENSIONS ARE IN INCHES.
DIMENSIONS SHOWN (XXX) ARE
REFERENCE DIMENSIONS. FOR
FINAL CONTROLLING DIMENSIONS
SEE THIS DRAWING SHEET #2
DETAIL "A" AND SECTION "A-A"
AND DRAWING SE131-003

(3.47)
1/8" THICK
INSULATED
AREA

(3.98)
IN 3/8" THICK
INSULATED
AREA ONLY

1 Drawings prepared
in accordance with
ASME Y14.100 - 2000
2 Interpret Dimensions
Tolerances per
ASME Y14.5M - 1994

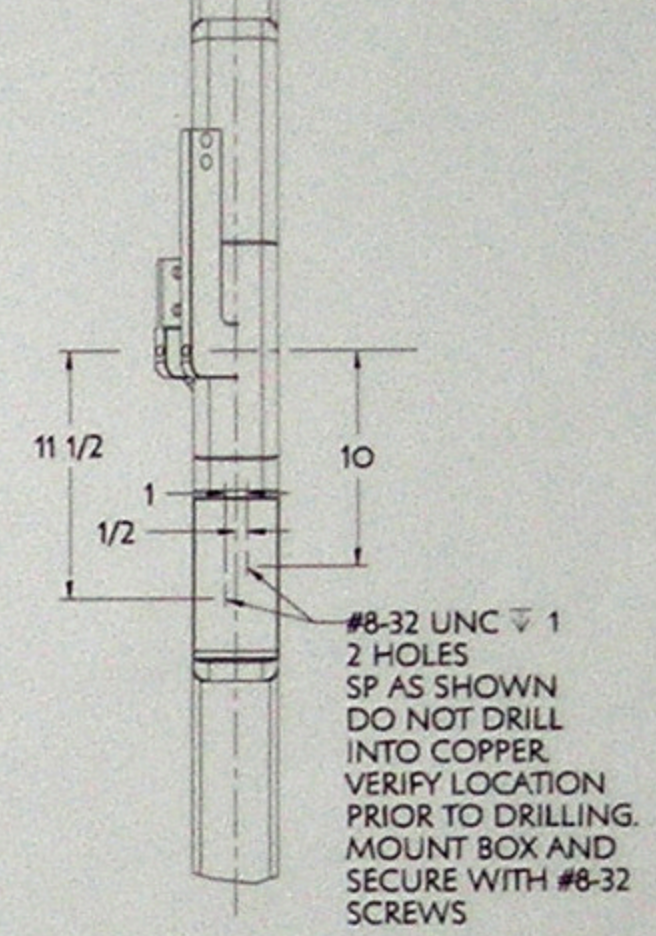

NOTE
LOCATION OF CENTROID OF COIL MUST BE
POSITIONED WITH THE ACCURACY REQUIRED
TO MEET THE TOLERANCES DEFINED IN THE
FINAL ASSEMBLY DRAWING SE131-003.

TWIST PART #1 (WIRE)
STARTING AT THIS
LOCATION AND FEED
INTO MOUNTED BOX.
(WIRES SHOWN FOR CLARITY.)
WIRES ARE INSTALLED PRIOR
TO INSTALLING THE LAST
LAYER OF GROUNDWRAPPING.

NOTE
DRAWING DEPICTS COIL WITH
RIGHT LEAD ORIENTATION (SE131-005-01)
MADE FROM SE131-035-01

Handwritten notes:
- XX TF COIL CONDUCTOR
NCSX CBPEL-131-02-00
MATERIAL
AR
QTY

REV	DESCRIPTION	DATE	BY	CHKD	APP'D
5	THIS DWG				
4	SE131-005				
3	SE131-035				
2	DIAGNOSTIC LOOP BOX				
1	DIAGNOSTIC LOOP WIRE				

PART NO.	DRAWING NO.	NOMENCLATURE OR DESCRIPTION	MATERIAL	QTY	REQD

WEIGHT	MODEL NAME	SCALE	DATE
1192.8 lbs	SE131-005	0.250	2/21/04

COMPUTER GENERATED DRAWING	CENTRAL FILED	PRINCETON PLASMA PHYSICS LABORATORY

REVISION	DESCRIPTION	DATE	BY	CHKD	APP'D

RELEASE LEVEL:
DWG VERSION NO:

(SEE SHT A)
 SHOULD NOT WE
~~BE~~ OPEN THE
 CONDUCTOR TO
 SHOW THE FERRULE?

Notes
 1. Drawings prepared in accordance with ASME Y14.100-2000
 2. Interpret Dimensions & Tolerances
 NOTE ~~on ASME Y14.5M-1994~~ ASME Y14.5M-1994
 ALL DIMENSIONS SHOWN IN INCHES.

Why does sht 2 have an separate parts list? why would you just add 16 #17 to sht 1?
 SHEET #1 DEPICTS COIL ASSEMBLY WITH RIGHT LEAD ORIENTATIONS.
 SEE SHEET #2 FOR LEFT LEAD ORIENTATIONS AND B/M PARTS.

I would callout the conductor somewhere with the drawing package. This may not be the best. But is confusing if it is not called out.
 SE131-035-01 (RIGHT LEADS)
 Very Confusing



1	-1	TF COIL CONDUCTOR	NCX-CSPCL-131-02-00	AR
Part No	PART OR PNG NO			

PART NO.	DRAWING NO.	NOMENCLATURE OR DESCRIPTION	MATERIAL	QTY	REQD
13	THIS DWG	52 GLASS INSULATION 1" WIDE X .003 THK			AVR
14	THIS DWG	KAPTON INSULATION 1" WIDE X .0035 THK WITH ADHESIVE	KAPTON		A/P
12	SE131-091	TF COIL FRONT TRANSITION FILLER DETAIL	S-11 CR	1	
10	SE131-087	SPACER FILLER BLOCK	S-11 CR	1	
11	SE131-084	LEAD LOCKING BLOCK SMALL	S-11 CR	1	
10	SE131-079	LEAD SUPPORT BLOCK LOCKING	S-11 CR	1	
9	SE131-078	LEAD SUPPORT LOCKING BLOCK TYPE "A"	S-11 CR	1	
8	SE131-054	TF COIL LEAD SHORT BENT RIGHT	COPPER COI	1	
7	SE131-053	TF COIL LEAD LONG BENT RIGHT	COPPER COI	1	
6	SE131-047-R2	TF COIL LEAD LOCKING BLOCK CENTRAL	S-11 CR	1	
5	SE131-042	SOMEL PIN 1/2 DIA. X 3" LONG	S-11 CR	5	
4	SE131-041	LEAD FILLER	S-11 CR	2	
3	SE131-033	FERRULE TYP 00 X 5/16 OD X 1 1/2 LS	S-11 CR	5	
2	SE131-032	TF COIL TRANSITION FILLER LEFT/RIGHT	S-11 CR	2	
1	SE131-031	TF COIL TRANSITION FILLER CENTER	S-11 CR	1	

COMPUTER GENERATED	CENTRAL FILED	PRINCETON PLASMA PHYSICS LABORATORY
MANUAL CHANGES NOT PERMITTED	UNLESS OTHERWISE SPECIFIED	REACTOR DIVISION
SCALE 1000	TOLERANCES NON-CUMULATIVE	DESIGN: RUSH/ARI
SCALE 1000	TOLERANCES NON-CUMULATIVE	CHK: W. KALISW. PAUL
SCALE 1000	TOLERANCES NON-CUMULATIVE	ENGR: W. KALISW
SCALE 1000	TOLERANCES NON-CUMULATIVE	SUPP: J. SIEBEL

RELEASE LEVEL: DWG VERSION NO:

WEIGHT: 1054.7 lbs
 MODEL NAME: SE131-035
 NATIONAL COMPACT STELLARATOR EXPERIMENT
 STELLARATOR CORE CONVENTIONAL COILS
 TF COIL WINDING ASSEMBLY/DETAILS
 SE131-035
 SHEET 1 OF 6

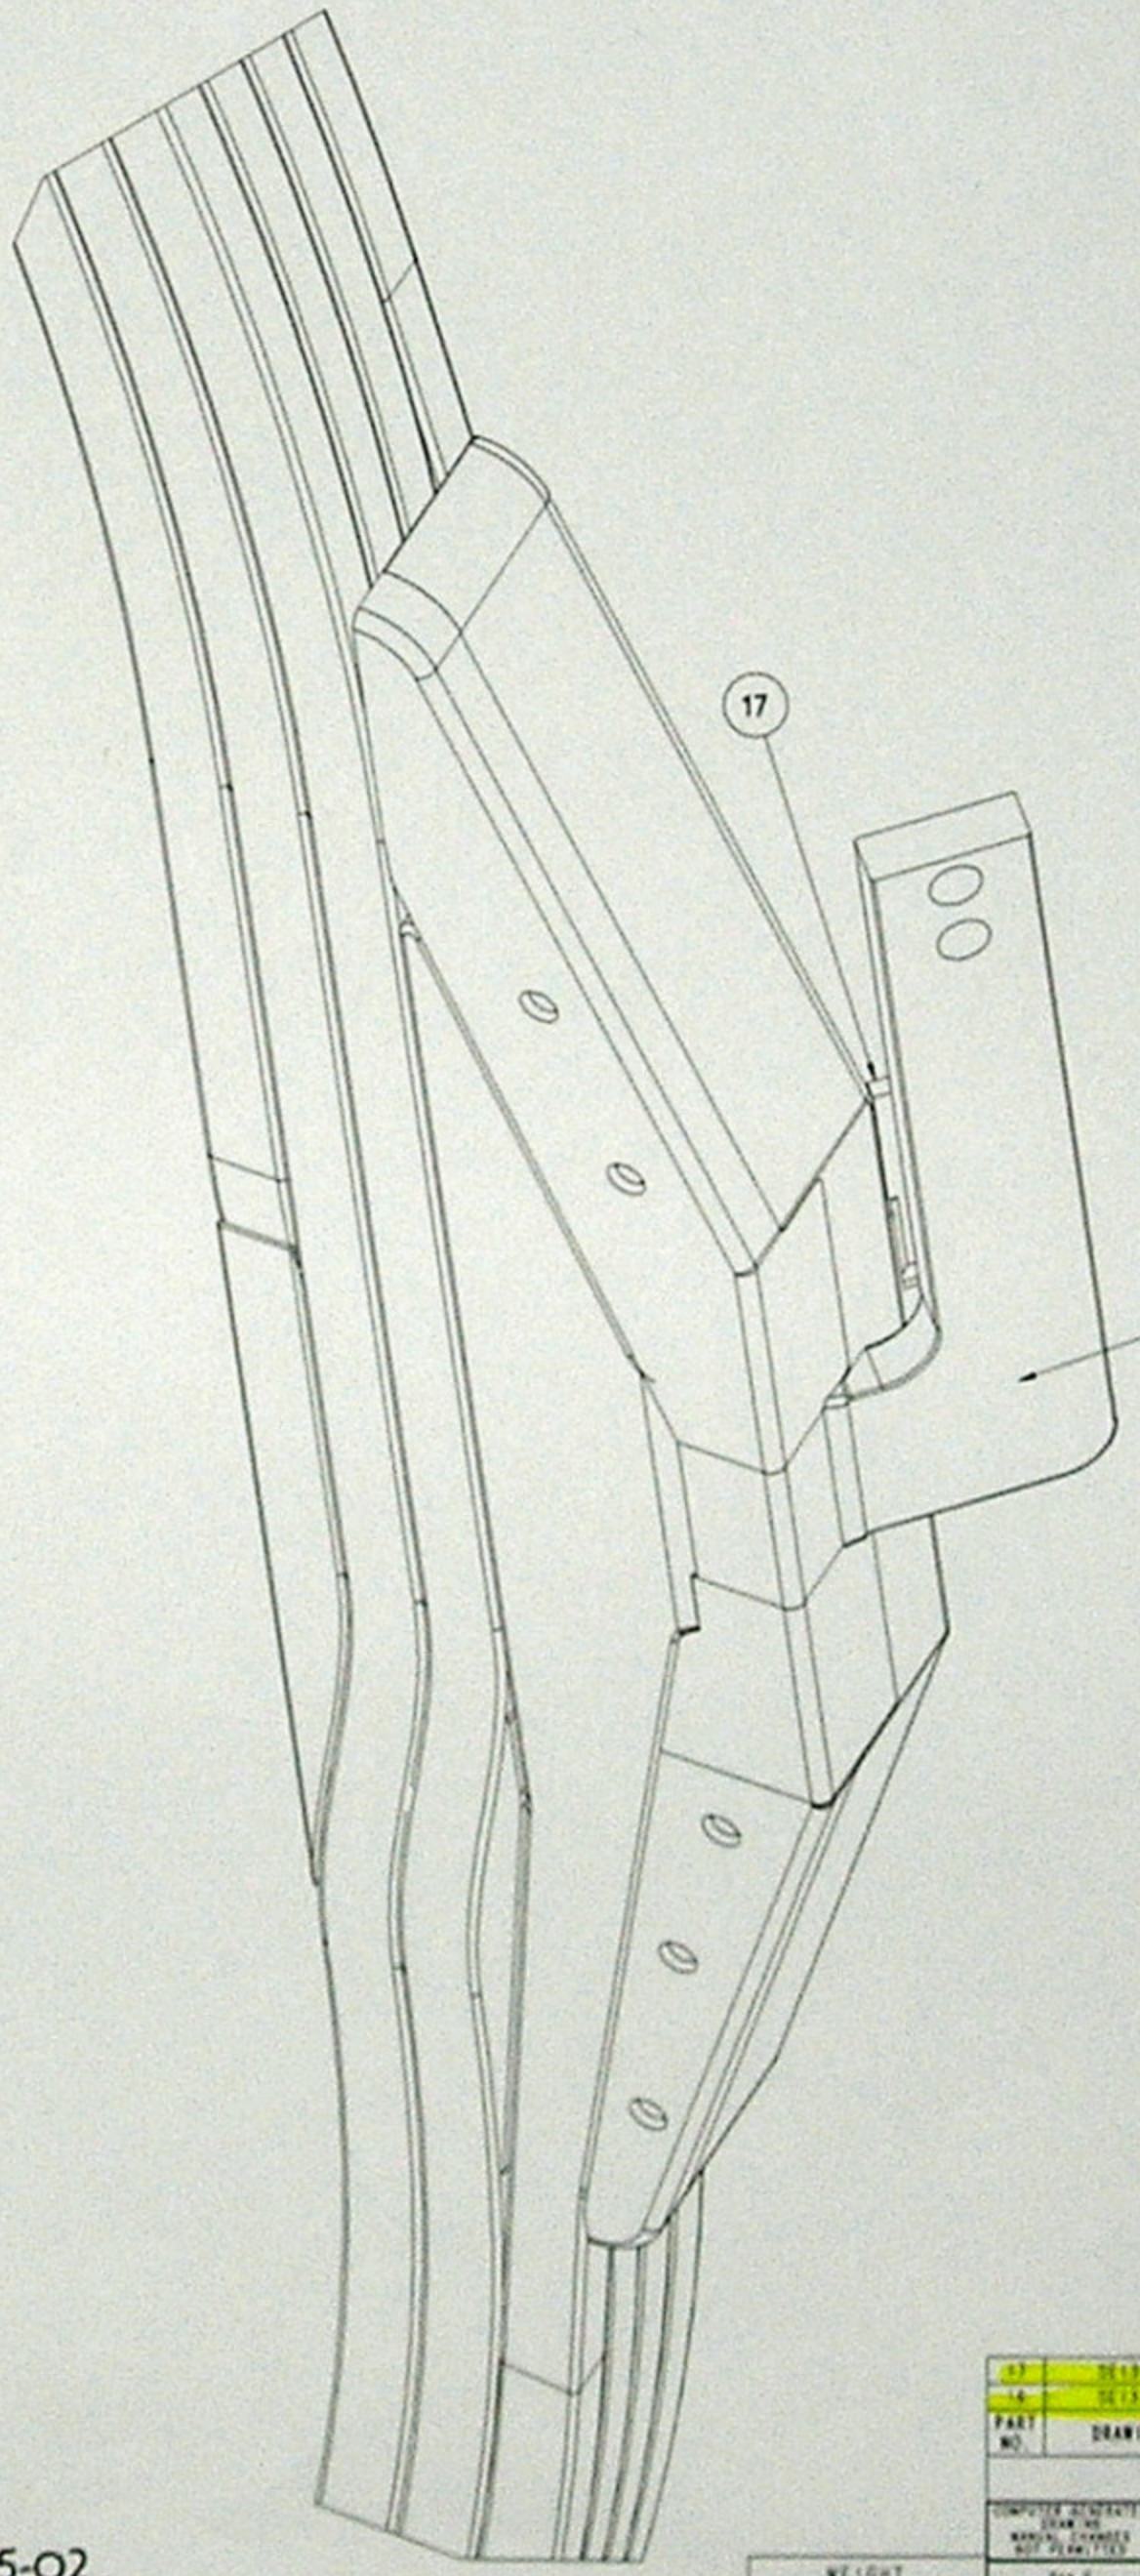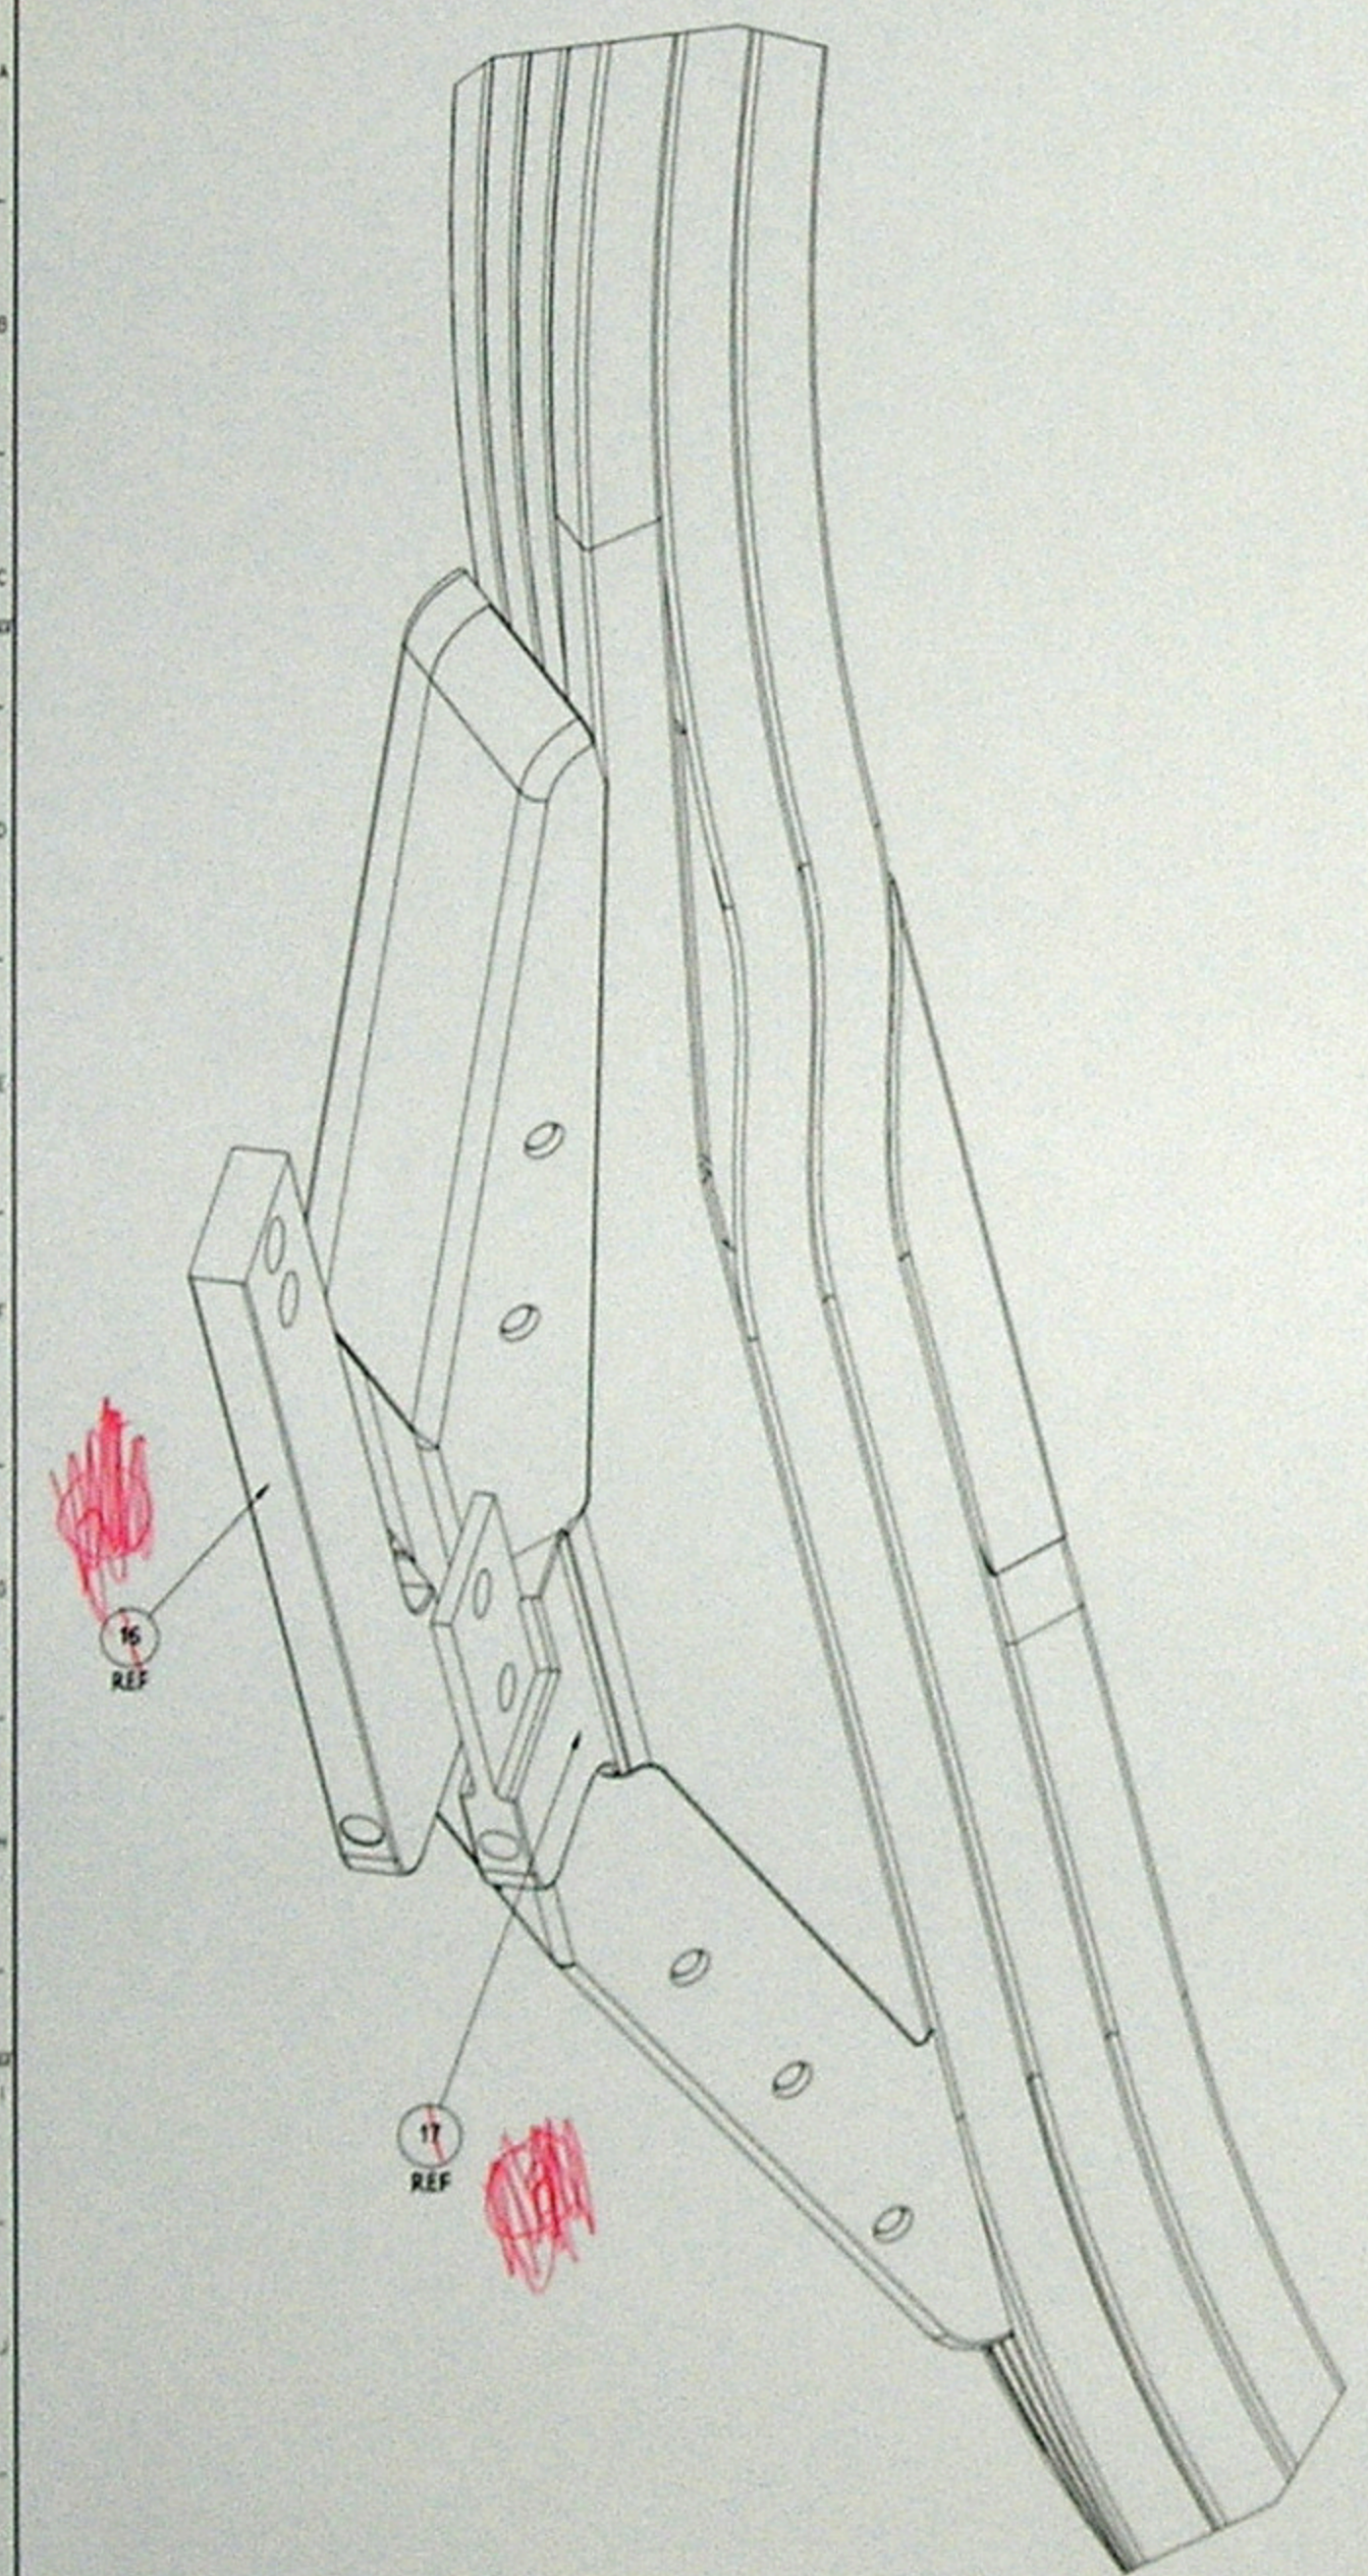

SE131-035-02
(LEFT LEADS)

It says left lead based on the drawing they look right very confusing!


RELEASE LEVEL WIP
DWO VERSION NO. 2

PART NO.	DRAWING NO.	NOMENCLATURE OR DESCRIPTION	MATERIAL	QTY	REQD
03	SE131-035	TF COIL LEAD SHORT BEAT LEFT			
04	SE131-035	TF COIL LEAD LONG BEAT LEFT			

PARTS LIST					
COMP. OR SUB-ASSEMBLY	QTY	DESCRIPTION	PRINCETON PLASMA PHYSICS LABORATORY	PRINCETON UNIVERSITY	NATIONAL COMPACT STELLARATOR EXPERIMENT

WEIGHT	1054.7 lbs
MODEL NAME	SE131-035

DESIGNED BY		DATE	
CHECKED BY		DATE	
APPROVED BY		DATE	

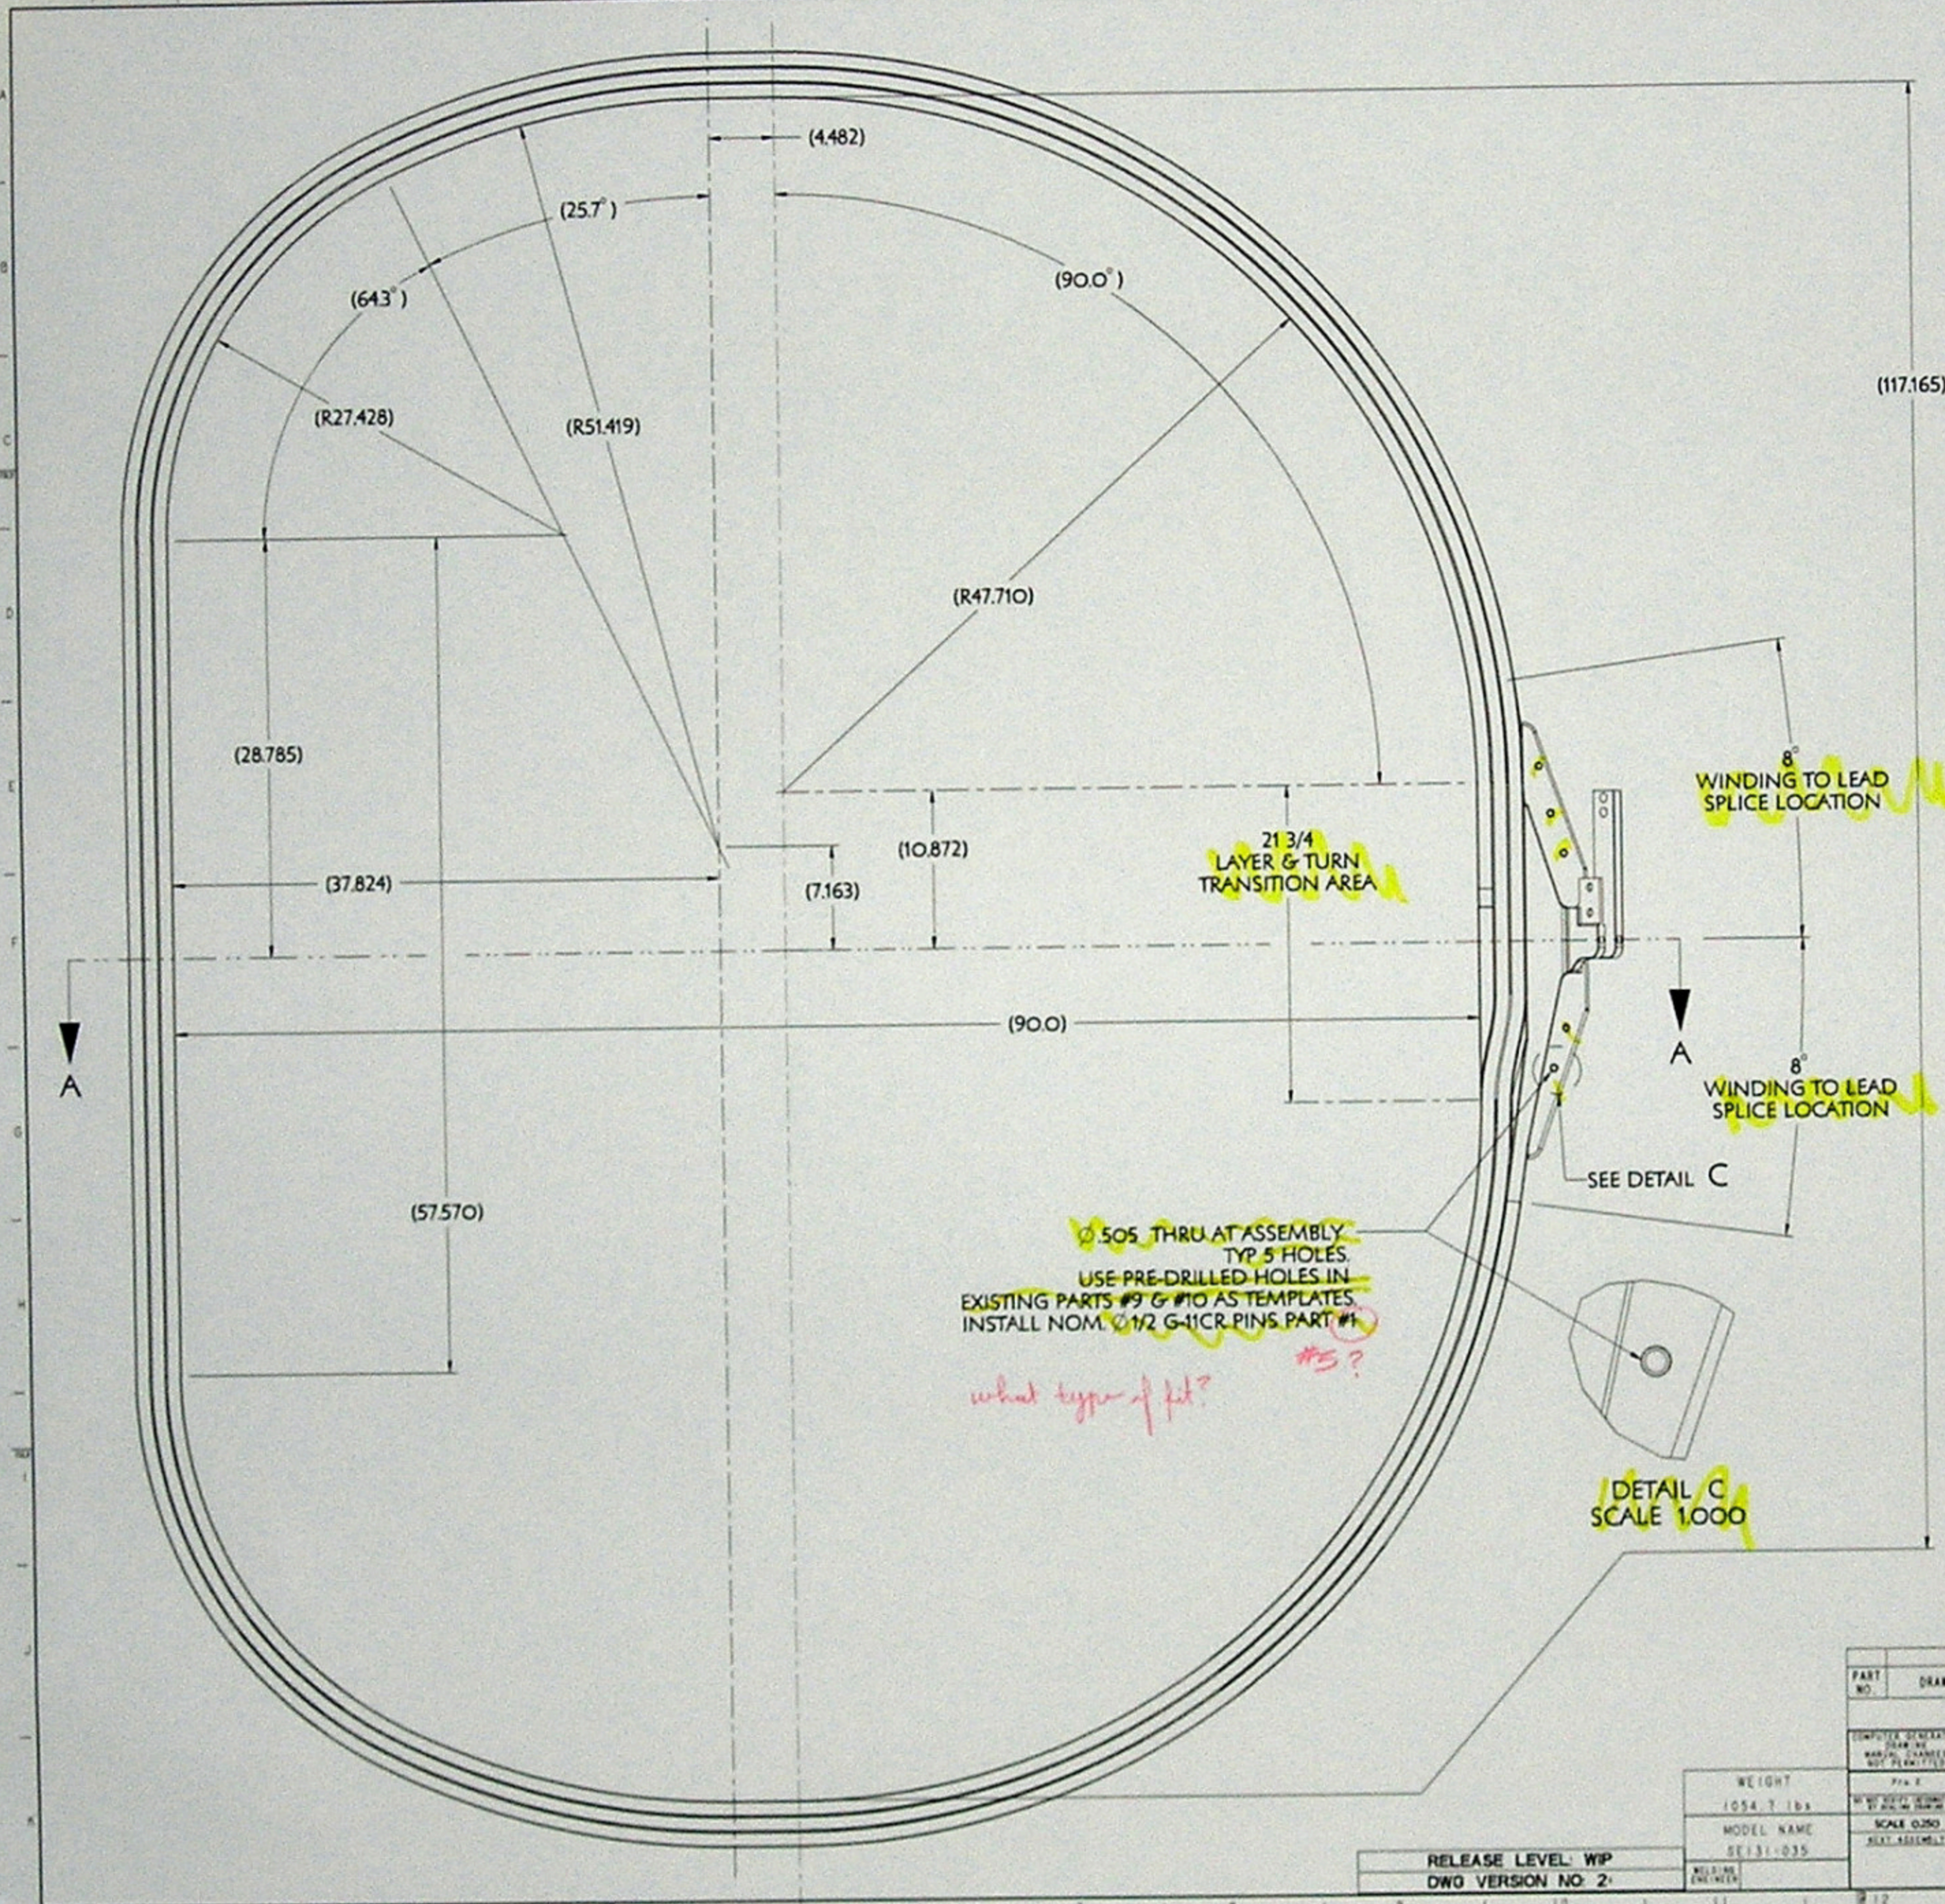


Ø .505 THRU AT ASSEMBLY
 TYP 5 HOLES
 USE PRE-DRILLED HOLES IN
 EXISTING PARTS #9 & #10 AS TEMPLATES
 INSTALL NOM. 1/2 G-11CR PINS PART #1
 #5?
 what type of fit?

8°
 WINDING TO LEAD
 SPLICE LOCATION

8°
 WINDING TO LEAD
 SPLICE LOCATION

DETAIL C
 SCALE 1000

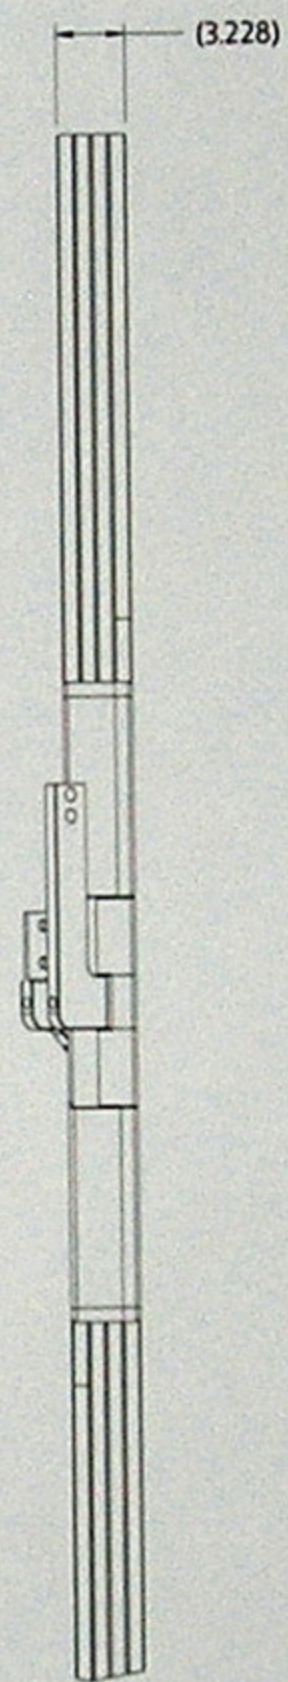




NOTE
 DIMENSIONS SHOWN (XXX) ARE
 REFERENCE DIMENSIONS.
 FOR FINAL CONTROLLING
 DIMENSIONS SEE DRAWINGS
 SE131-003 AND SE131-005
 DIMENSIONS INCLUDE TURN
 TO TURN INSULATION THICKNESS

RELEASE LEVEL: WIP
 DWG VERSION NO: 2

PART NO.	DRAWING NO.	NOMENCLATURE OR DESCRIPTION	MATERIAL	QTY	REQD
PARTS LIST					
COMPUTER GENERATED	CENTRAL FILE:	PRINCETON PLASMA PHYSICS LABORATORY PRINCETON UNIVERSITY			
MANUAL CHANGES NOT PLANNED	UNLESS OTHERWISE SPECIFIED:	NATIONAL COMPACT STELLARATOR EXPERIMENT			
WEIGHT	SCALE 0.250	STELLARATOR CORE CONVENTIONAL COILS TF COIL WINDING ASSEMBLY/DETAILS			
1054.7 lbs	SCALE 0.250	DRAWING NO. SE131-035			
MODEL NAME	FILE ASSEMBLY	SHEET 3 OF 8			
SE131-035	FILE ASSEMBLY	REV 0			


NCSX-SE131-035

NO.	REVISION	BY	CHK	SUP	APPROVED	DATE

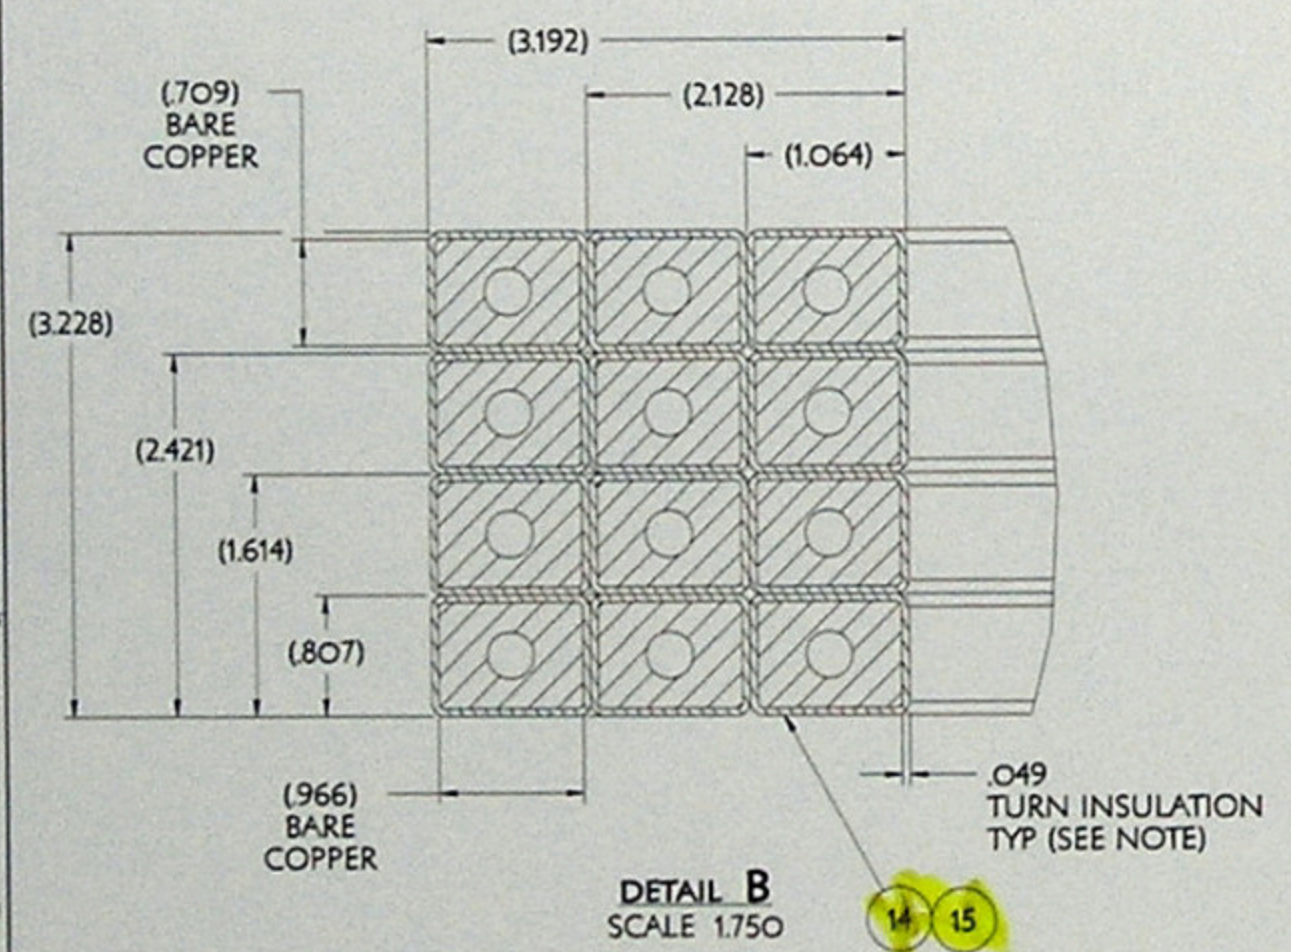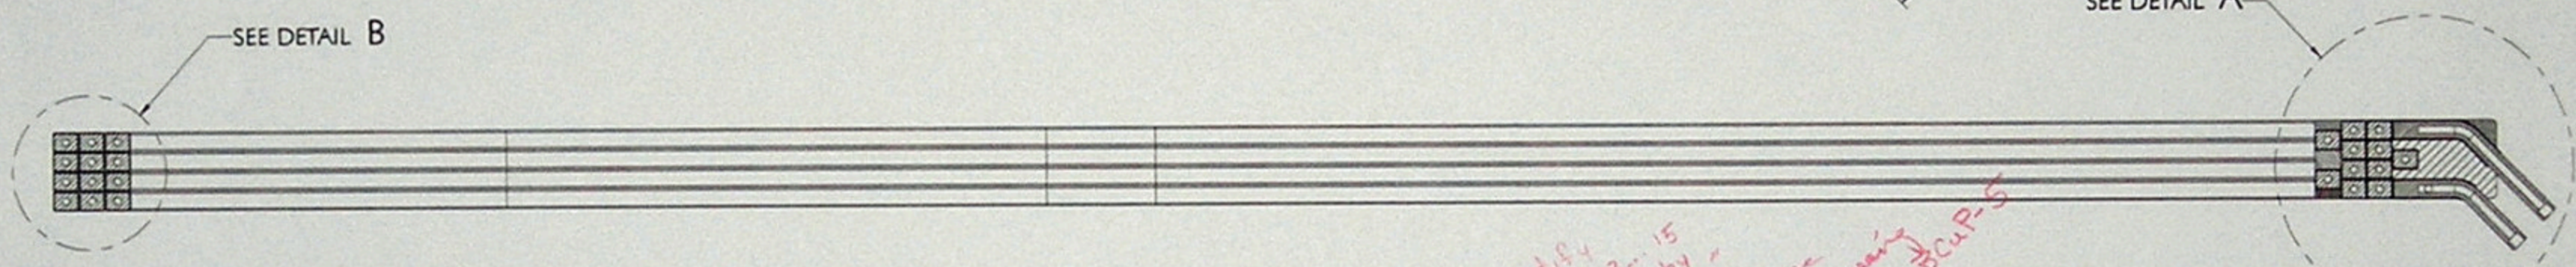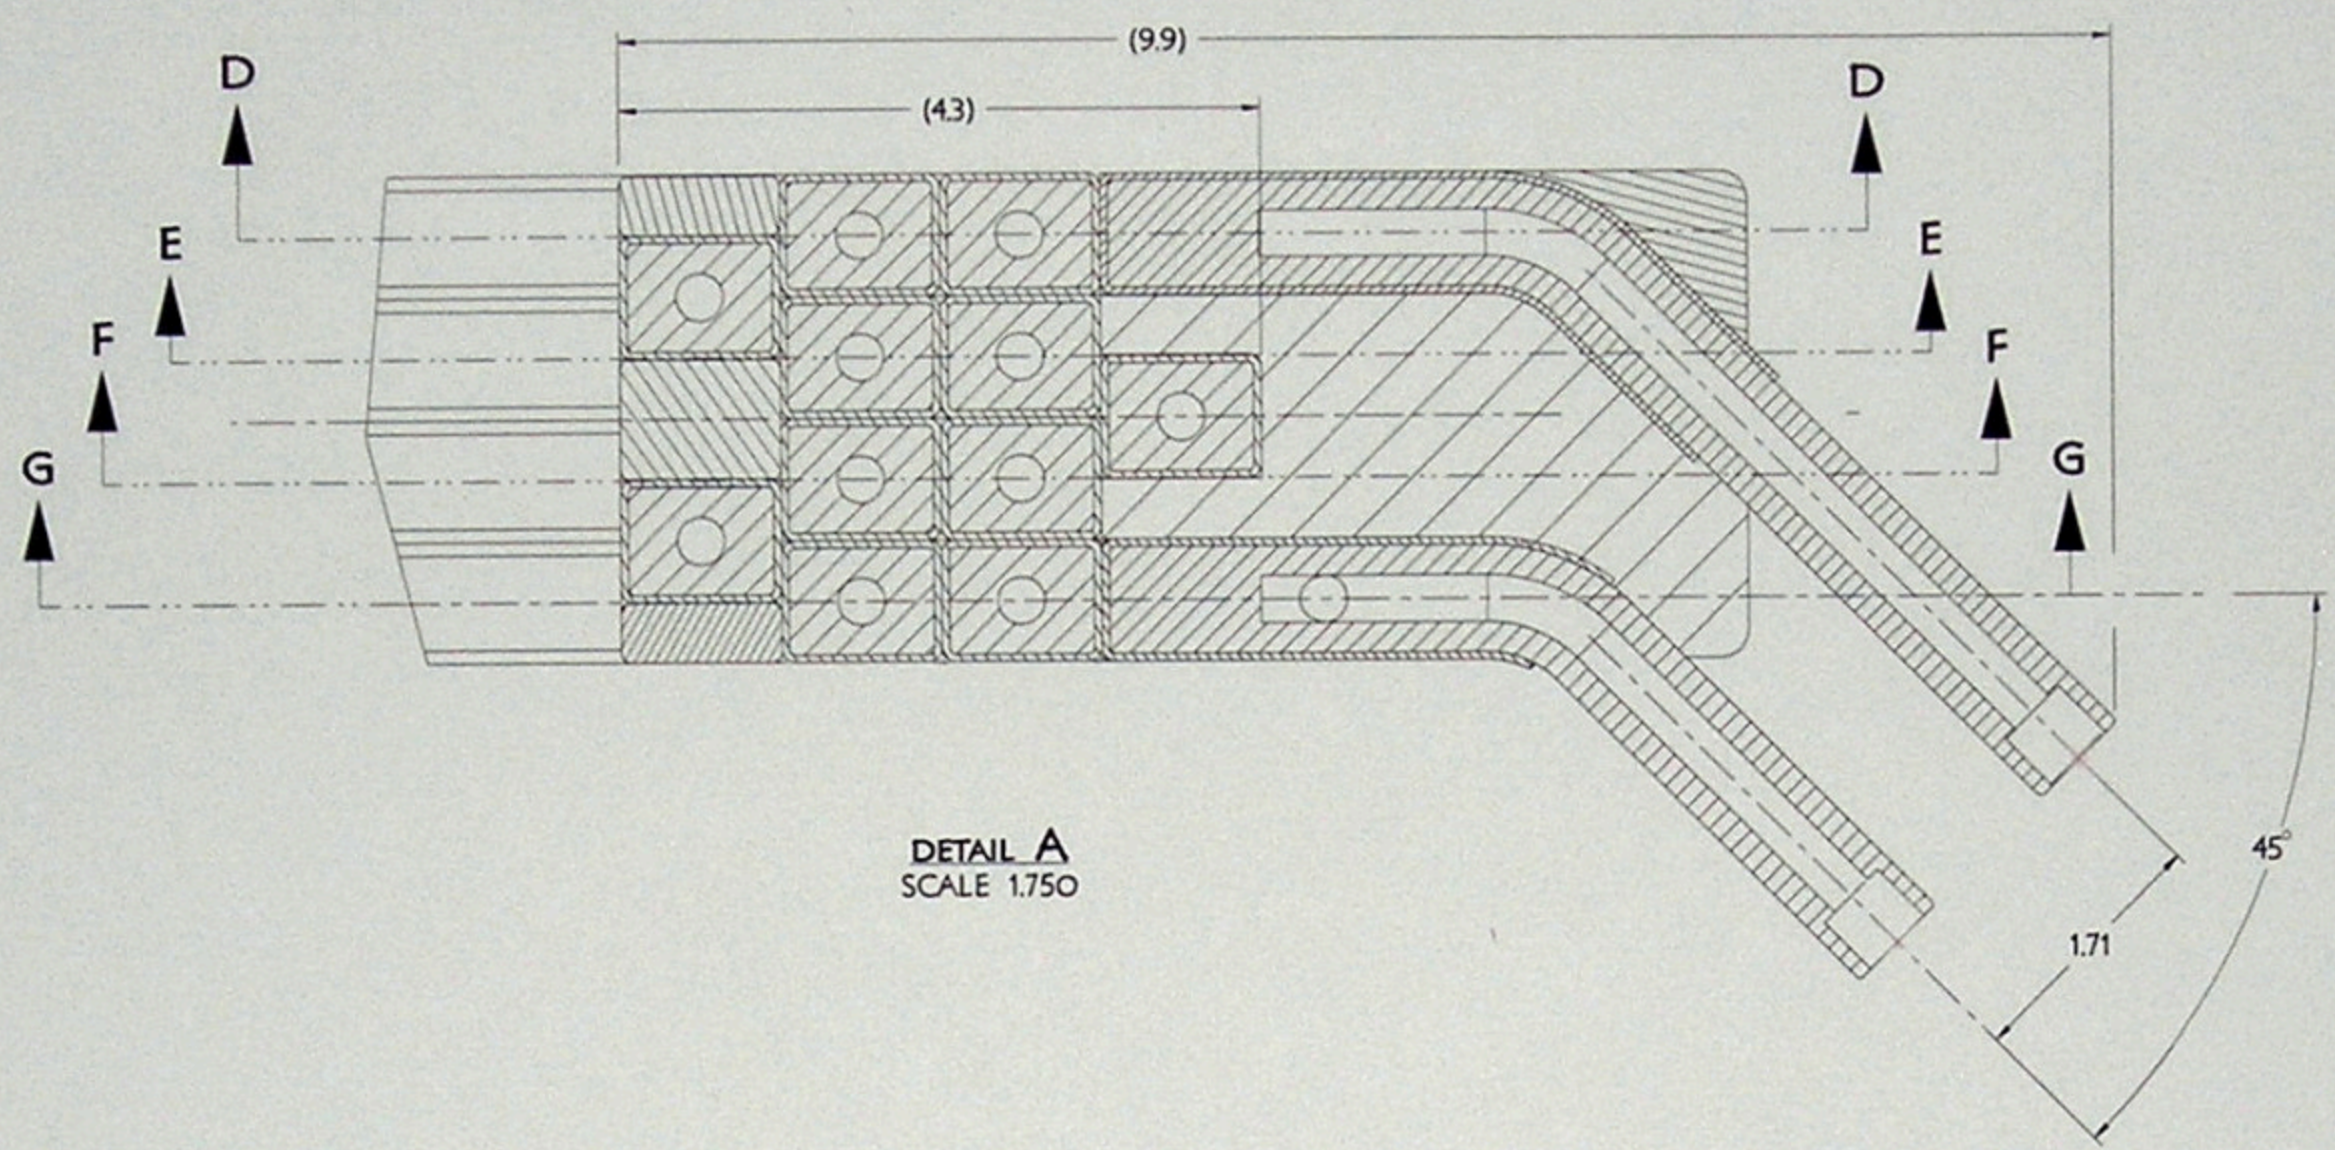

NOTE
 TURN INSULATION (APPROX .049" THICK)
 1 (1/2 LAPPED) LAYER KAPTON/ADHESIVE TAPE
 3 (1/2 LAPPED) LAYERS GLASS TAPE
 SEE SPECIFICATION NCSX-131-01-00 FOR TURN TO TURN INSULATION DETAILS.

SECTION A-A
 SCALE 0.375

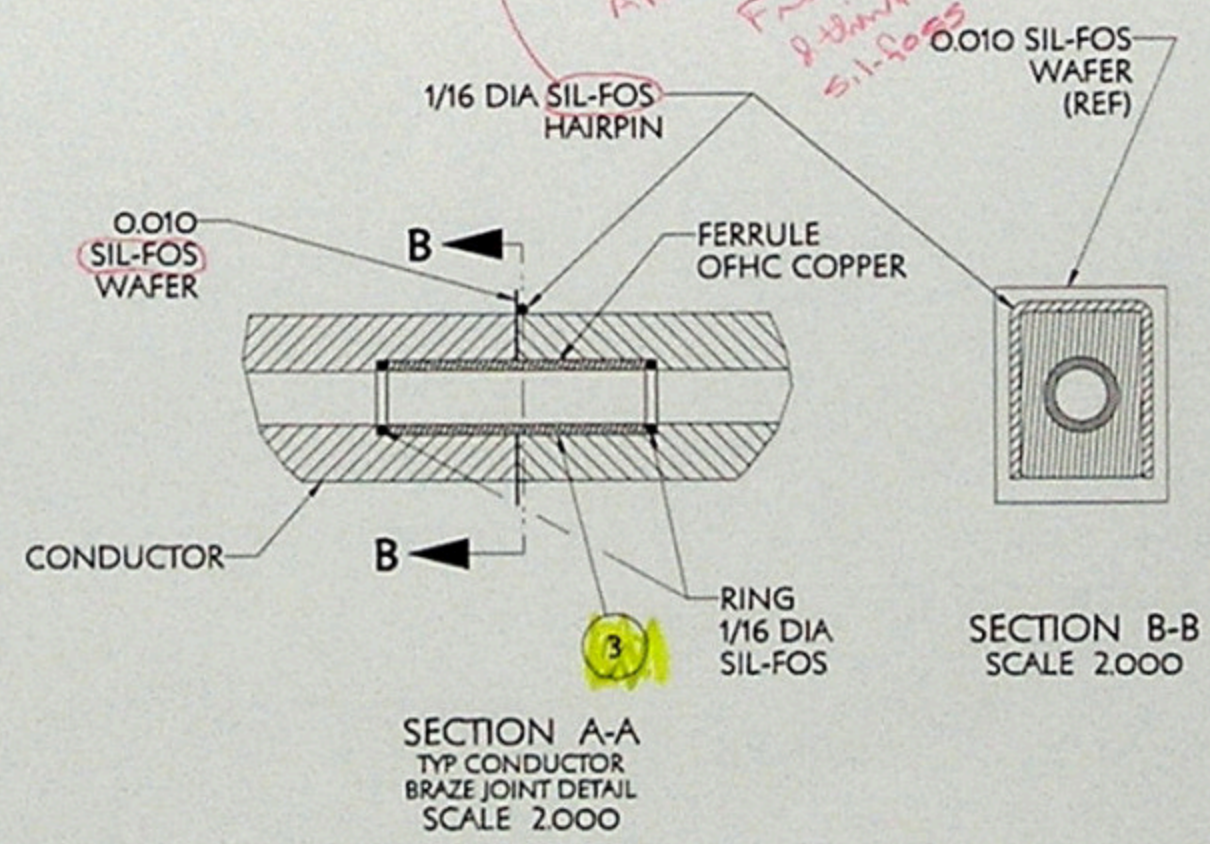

BRAZE NOTES

THE BRAZE JOINT SHALL CONSIST OF AN OXYGEN-FREE (OFHC) COPPER FERRULE (2) SIL-FOS RINGS AT THE END OF THE FERRULE, A SIL-FOS WAFER AND A SIL-FOS HAIRPIN TO SUPPLY ADDITIONAL BRAZE MATERIAL DURING THE PROCESS. THE HAIRPIN MAY BE REPLACED WITH HAND FED SIL-FOS MATERIAL.

THE COPPER FERRULE SHALL MAINTAIN THE ID OF THE COOLANT PATH IN THE CONDUCTOR. THE CLEARANCE HOLE IN THE CONDUCTOR END SHALL BE DRILLED TO ALLOW A 0.003 TO 0.005 INCH CLEARANCE BETWEEN THE FERRULE OUTER DIAMETER AND THE COUNTER BORED CONDUCTOR INNER DIAMETER.

SEE SPECIFICATION NCSX-CSPEC-131-01-00 FOR FURTHER BRAZE DETAILS AND REQUIRED QUALIFICATIONS.


BRAZED JOINTS SHALL BE VISUALLY EXAMINED FOR COMPLETE FILING OF THE JOINT AND FREEDOM FROM CRACKS.

SECTION B-B
 SCALE 2.000


PART NO.	DRAWING NO.	NOMENCLATURE OR DESCRIPTION	MATERIAL	QTY REQD
PARTS LIST				
PRINCETON PLASMA PHYSICS LABORATORY PRINCETON UNIVERSITY NATIONAL COMPACT STELLARATOR EXPERIMENT				
STELLARATOR CORE CONVENTIONAL COILS TF COIL WINDING ASSEMBLY/DETAILS				
COMPUTER GENERATED DRAWING MANUAL CHANGES NOT PERMITTED	CENTRAL FILED UNLESS OTHERWISE SPECIFIED	PRIN E	DR. J. ROBINSON	2/21/08
NO NEW REVIEWS WITHOUT BY DRAWING NUMBER	BREAK SHARP EDGES (SEE) ADD	DR. W. KALISH	PAUL	2/21/08
TOLERANCES UNLESS OTHERWISE SPECIFIED	DECIMALS FRACTIONS	ENG. M. KALISH	2/21/08	SEI31-035
WELDING END-NOTES	ASSEMBLY/DETAILS	SUPV. J. SIEGEL	2/21/08	SHEET 4 OF 6

RELEASE LEVEL: WIP
 DWG VERSION NO. 2


NCSX-SEI31-035

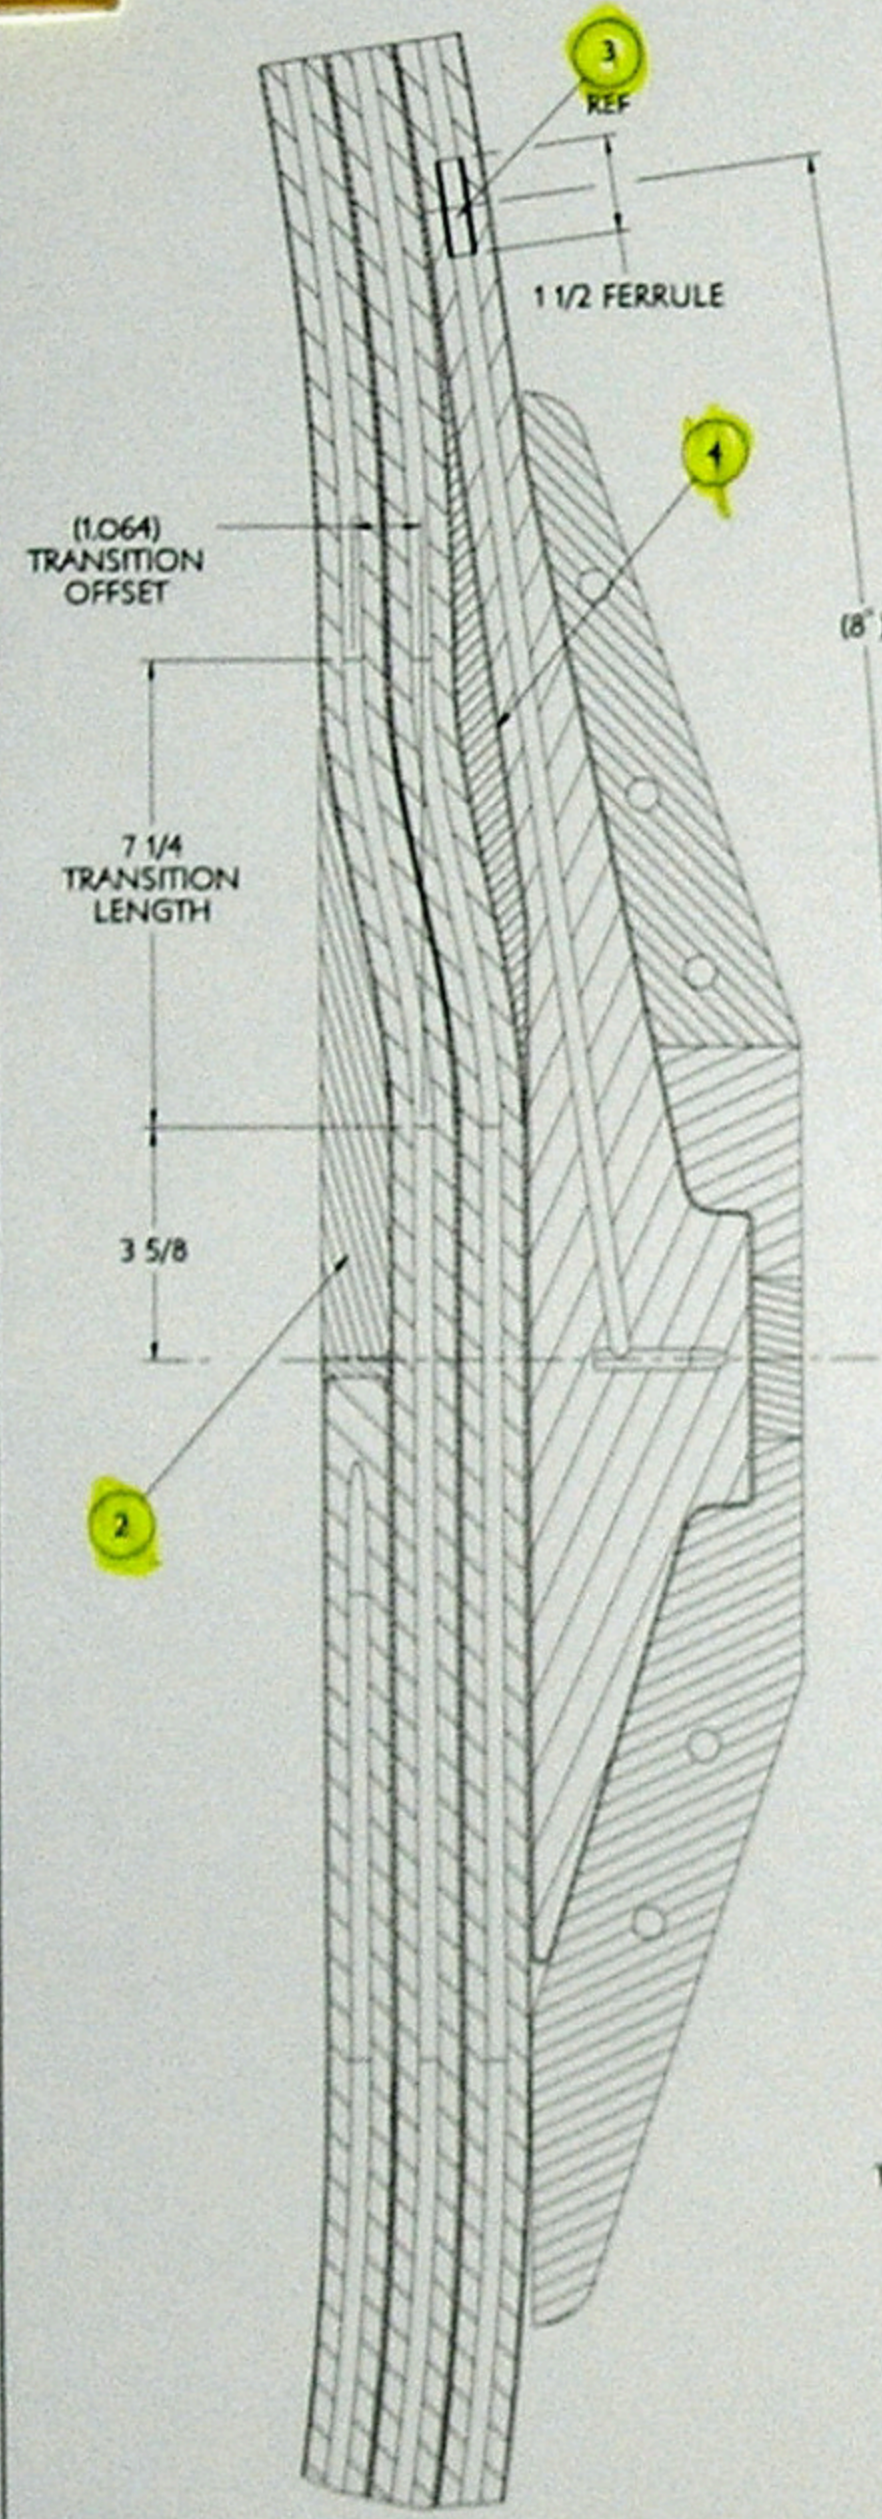


SECTION D-D
LAYER #1 TURN TRANSITIONS
SCALE 0.750

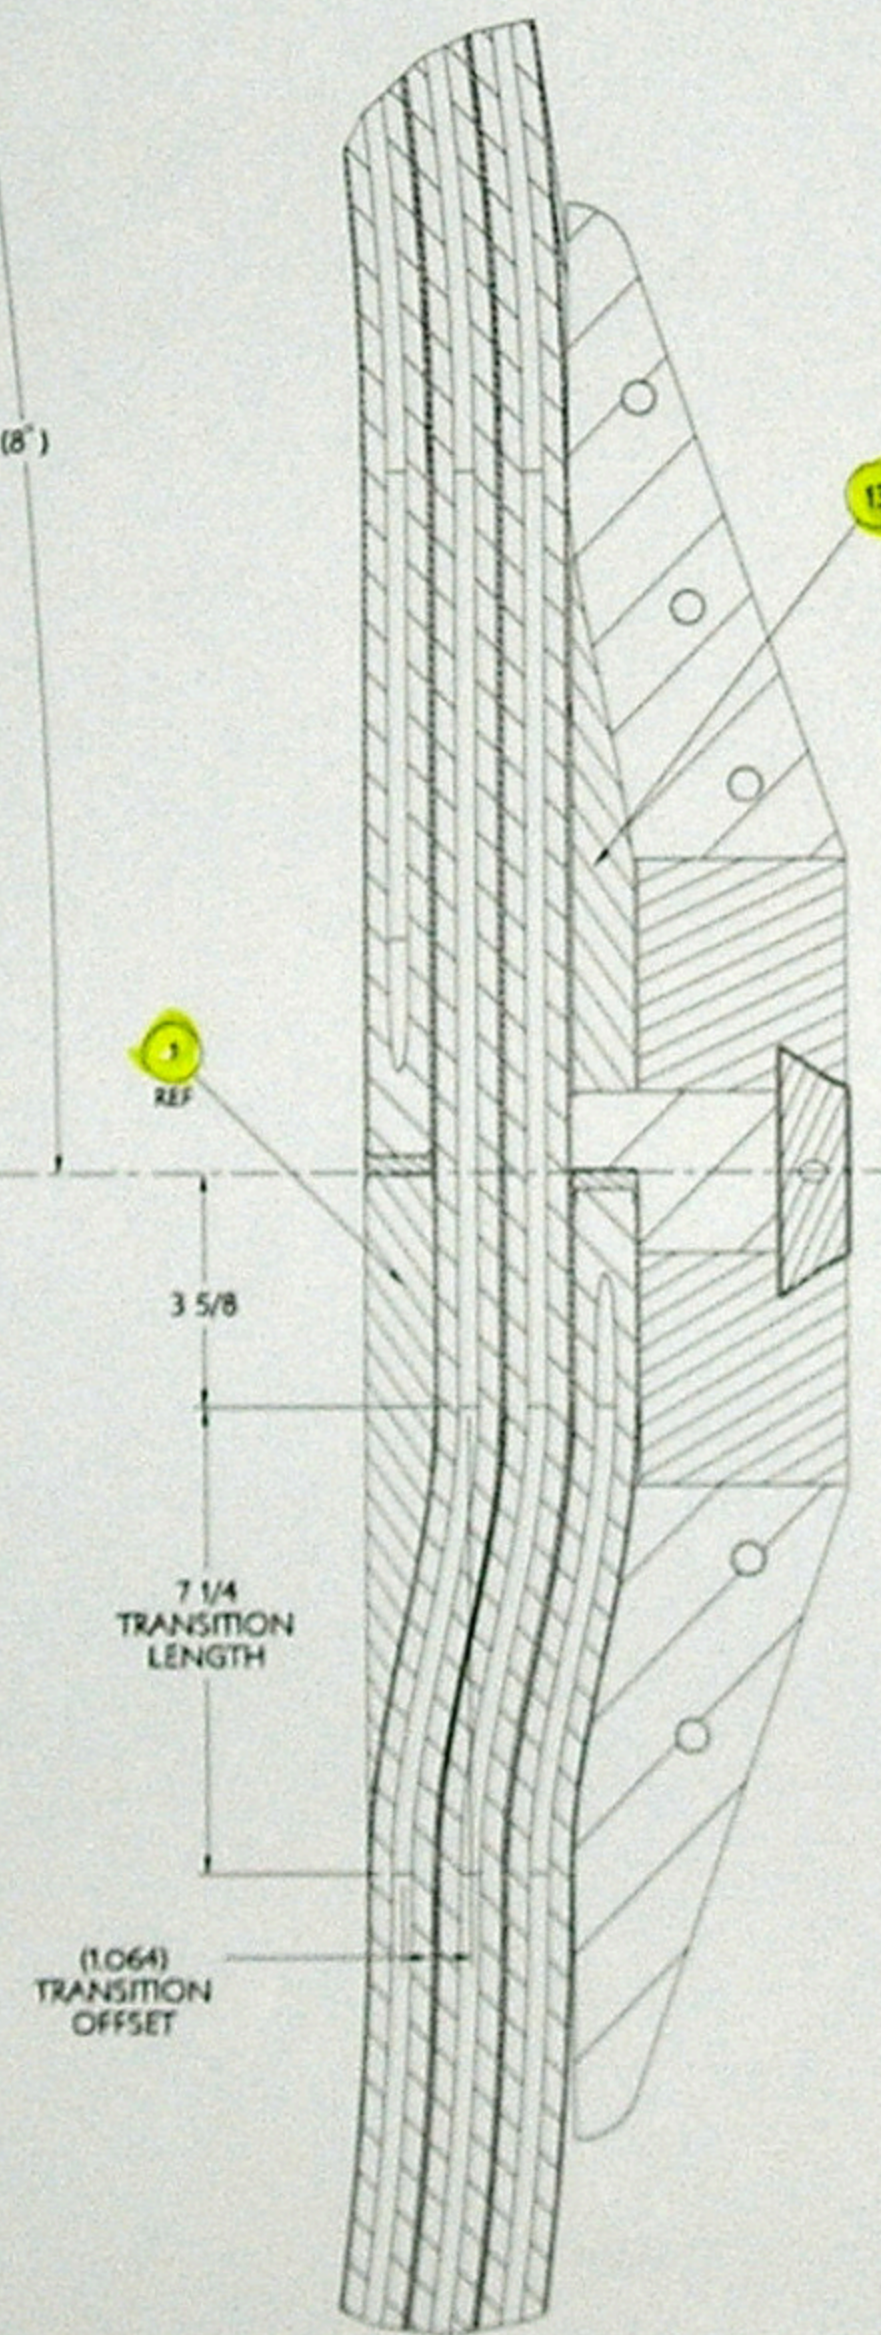

SECTION E-E
LAYER #2 TURN TRANSITIONS
SCALE 0.750

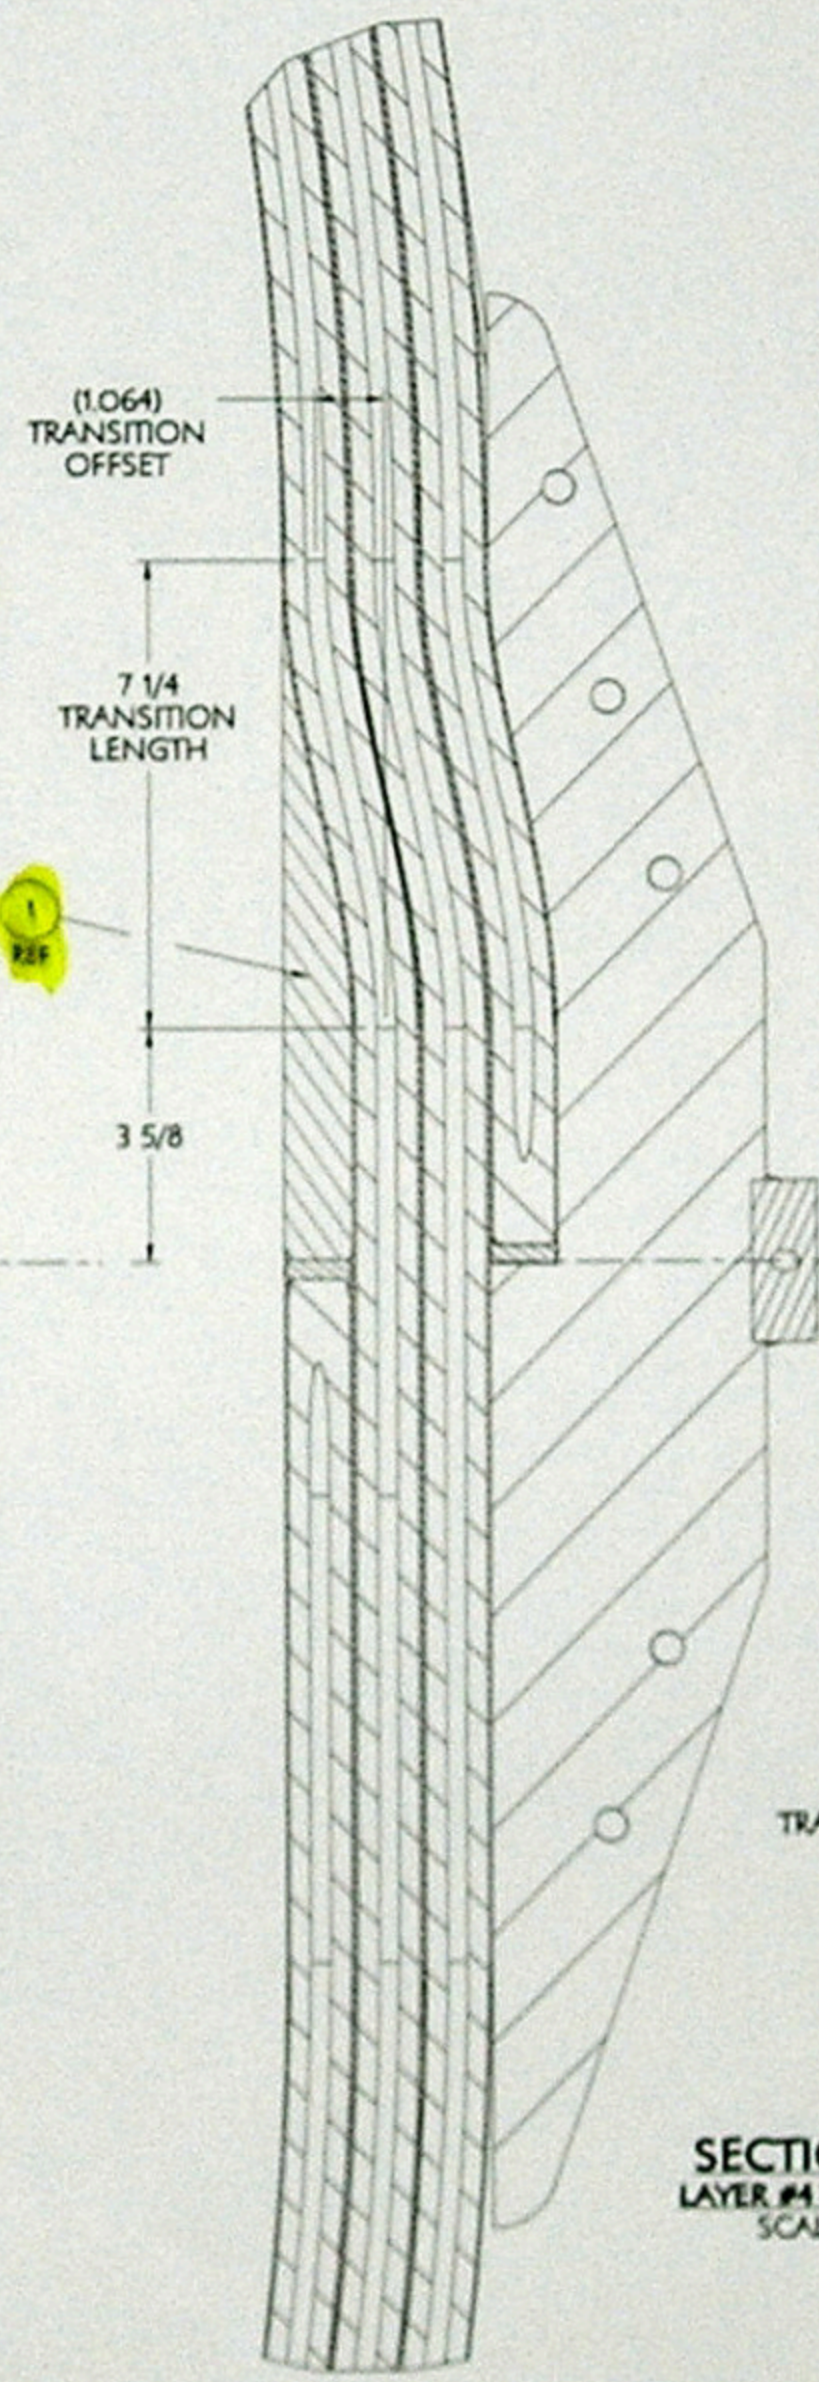


SECTION F-F
LAYER #3 TRANSITIONS
SCALE 0.750

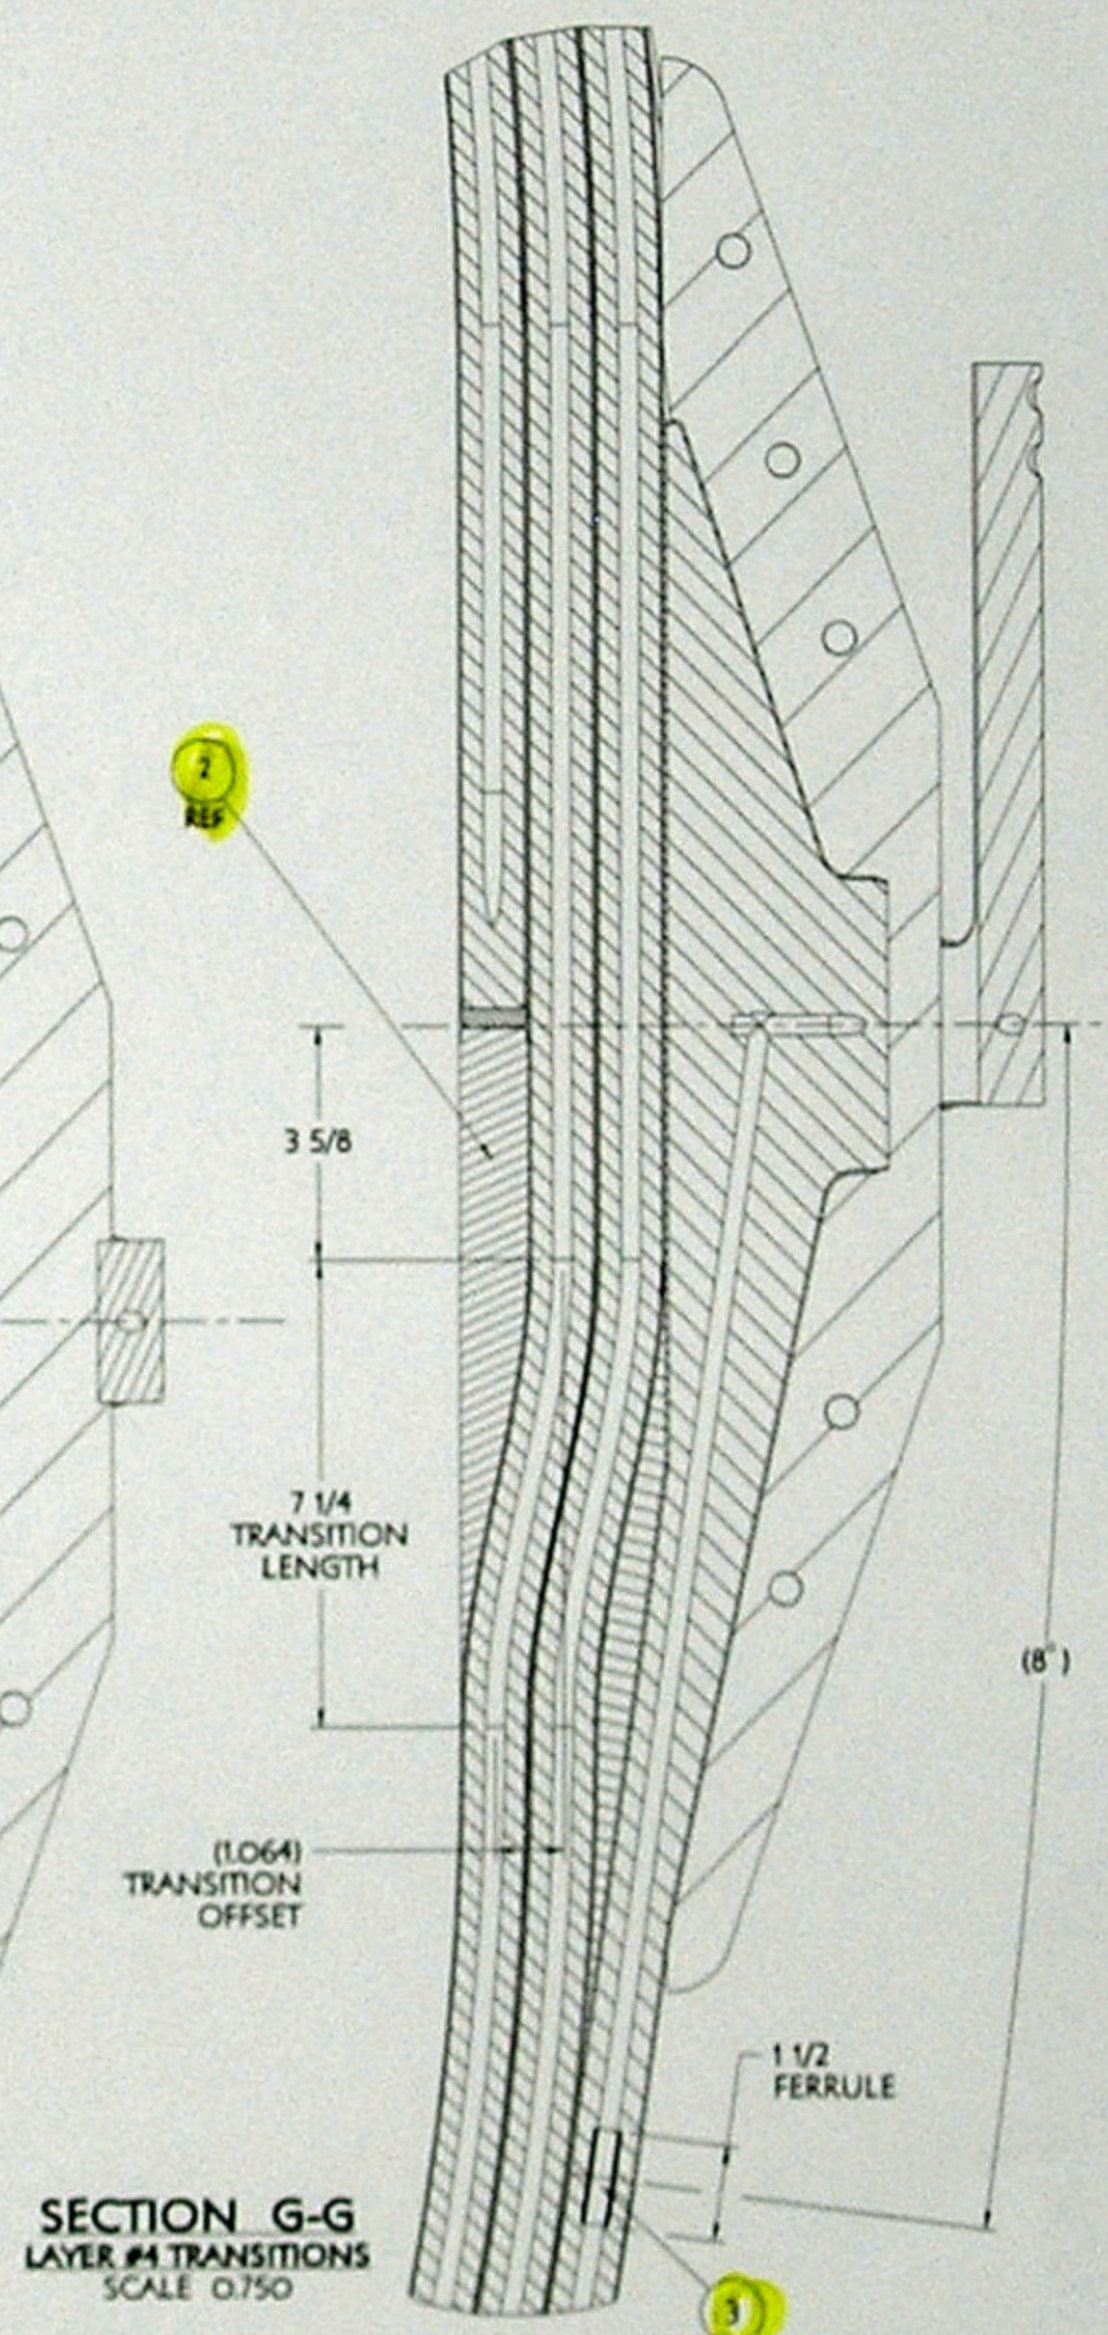


SECTION G-G
LAYER #4 TRANSITIONS
SCALE 0.750

RELEASE LEVEL: WP
DWG VERSION NO: 2

PART NO.	SEARCHING NO.	NUMERATURE OR DESCRIPTION	MATERIAL	QTY	REQD.
PARTS LIST					
PRINCETON PLASMA PHYSICS LABORATORY					
NATIONAL COMPACT STELLARATOR EXPERIMENT					
STEEL-BRETTON COILS					
CONVENTIONAL COILS					
TF COIL WINDING ASSEMBLY DETAILS					
5E131-035					
SHEET 5 OF 8					

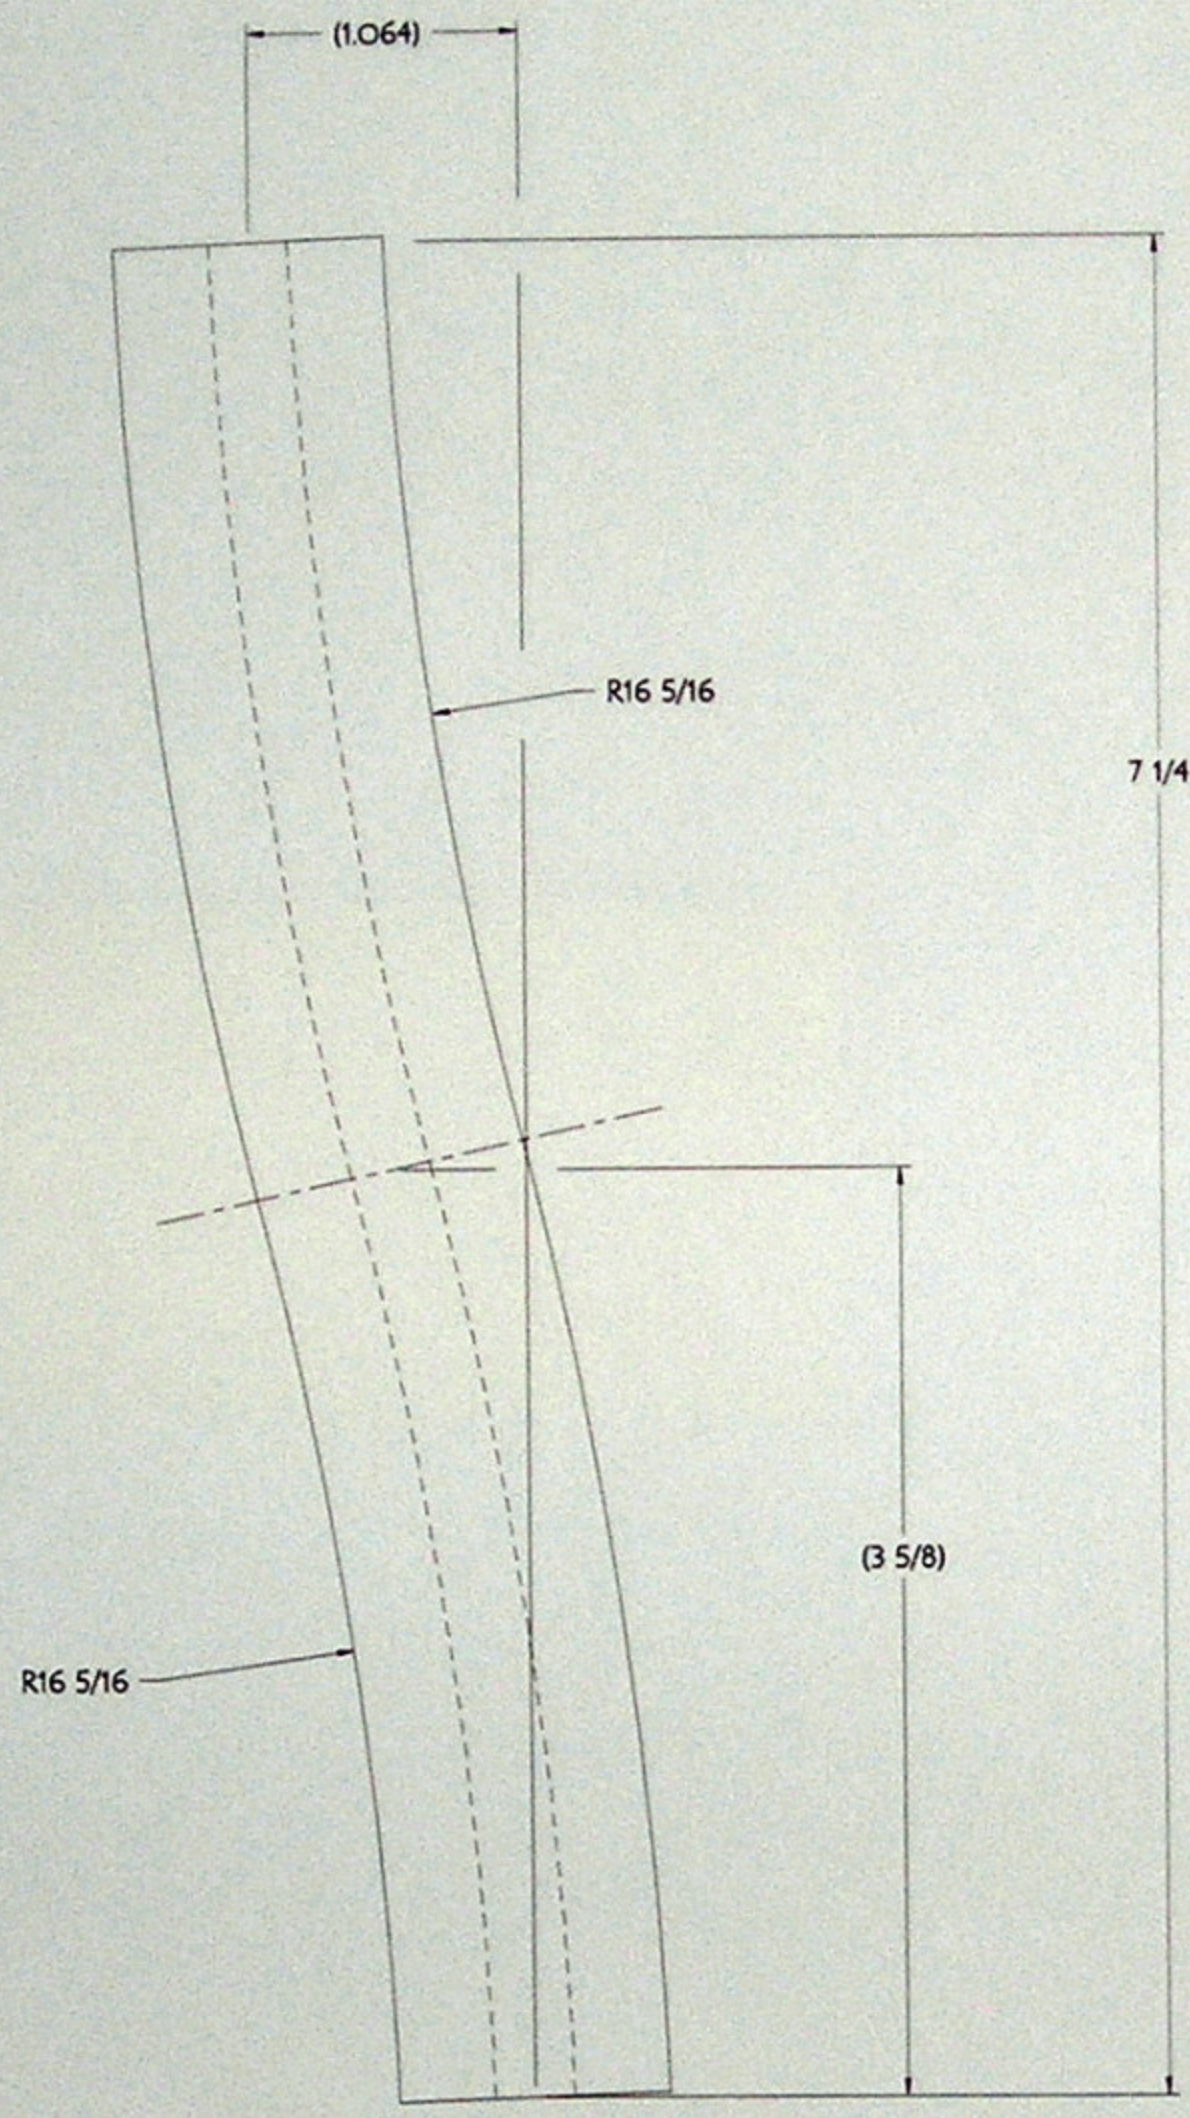



TYP TURN TO TURN TRANSITION
SCALE 3.000

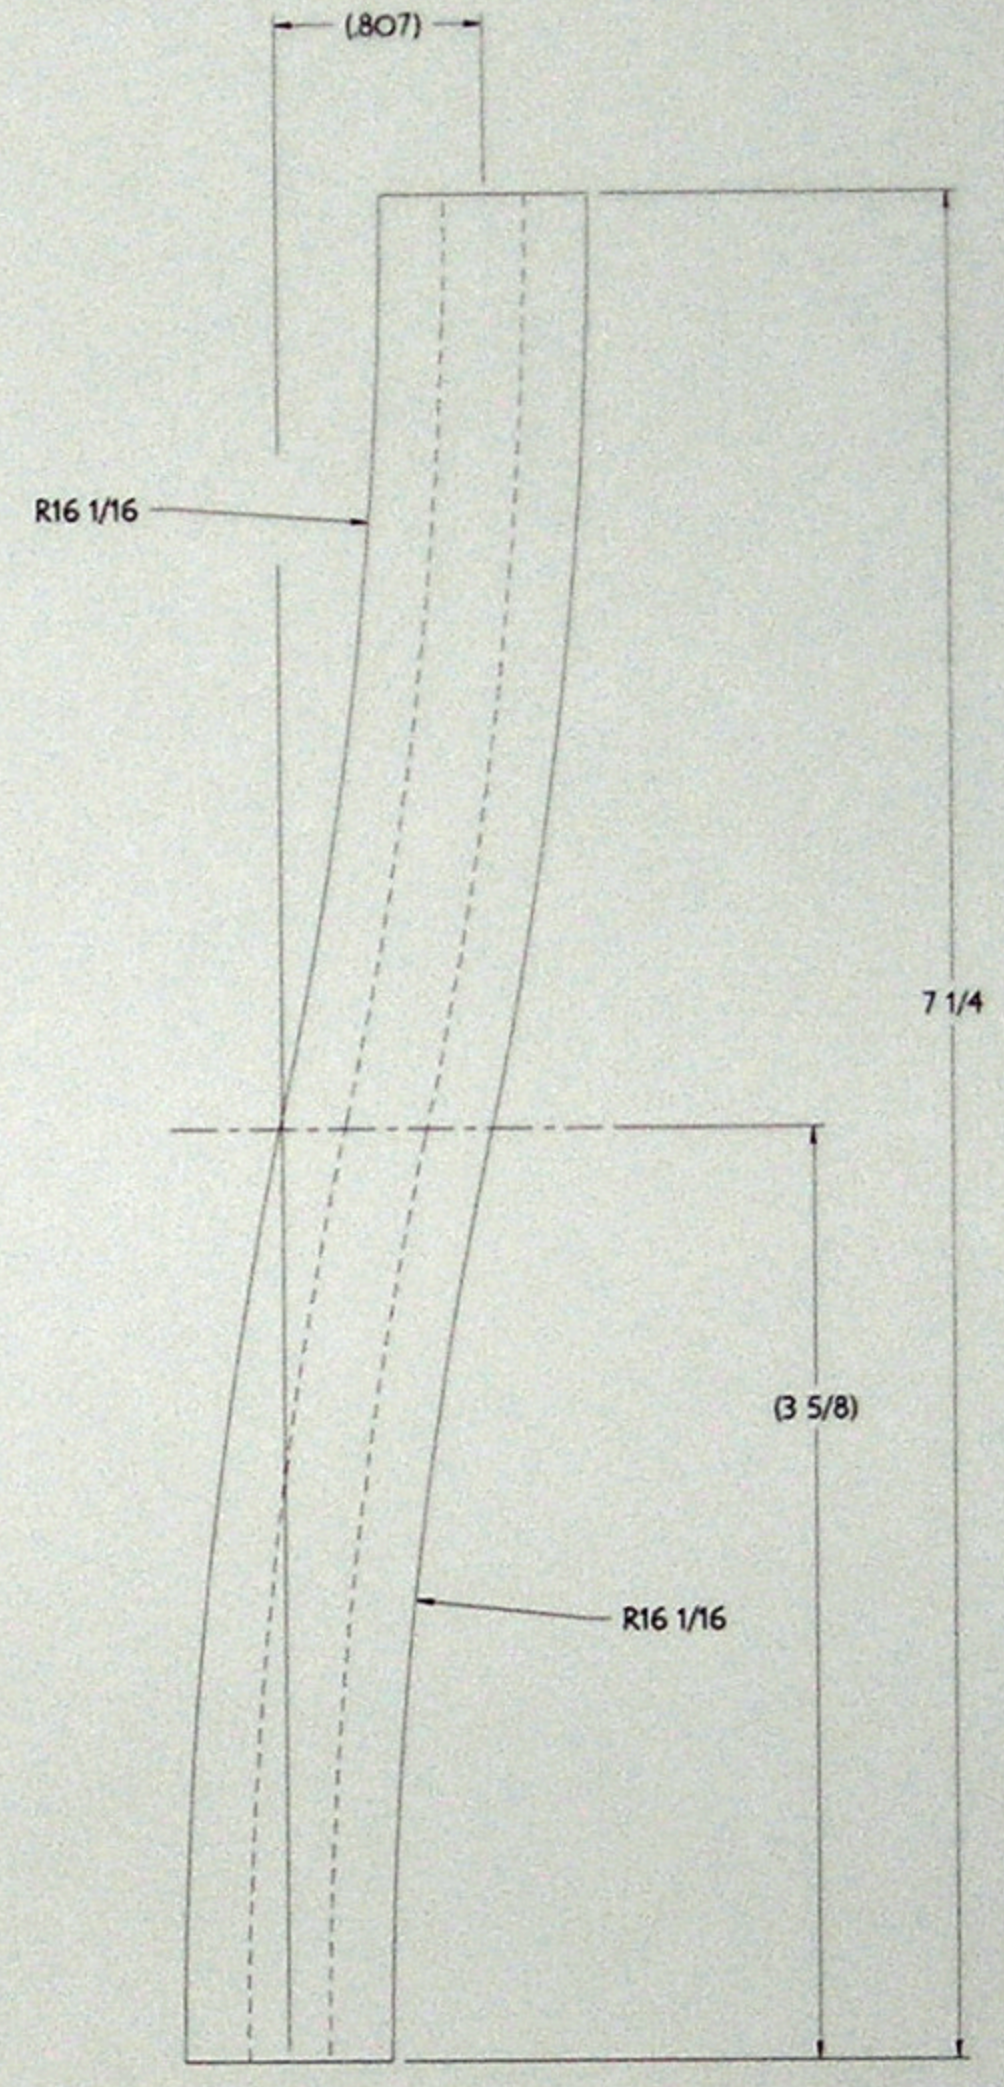

TYP LAYER TO LAYER TRANSITION
SCALE 3.000

PART NO.	DRAWING NO.	NOMENCLATURE OR DESCRIPTION	MATERIAL	QTY	REGR.
PARTS LIST					
COMPUTER GENERATED DRAWING MANUAL CHANGES NOT PERMITTED	CENTRAL FILE: UNLESS OTHERWISE SPECIFIED	PRINCETON PLASMA PHYSICS LABORATORY PRINCETON UNIVERSITY NATIONAL COMPACT STELLARATOR EXPERIMENT			
WEIGHT	P * E	DIMENSIONS ARE IN INCHES MACHINE SURFACES	STELLARATOR CORE CONVENTIONAL COILS TF COIL WINDING ASSEMBLY/DETAILS		
MODEL NAME	SE131-035	TOLERANCES - NON-CUMULATIVE	DRG. J. SIEBEL	2/21/78	DRAWING NO.
RELEASE LEVEL: WIP DWG VERSION NO: 2	WELDING ENG/MECH	REC'D: J. SIEBEL	CHK: W. KALISH, PAUL	2/21/78	SE131-035
		APP: W. KALISH	ENGR: W. KALISH	2/21/78	
		APP: W. KALISH	SUPV: J. SIEBEL	2/21/78	SHEET 6 OF 6

NO.	REVISION	BY	CHK	SUP	APPROVED	DATE
1	REVISED PER ECN #5073	JDR	MK	JS	M. KALISH	2/03/06

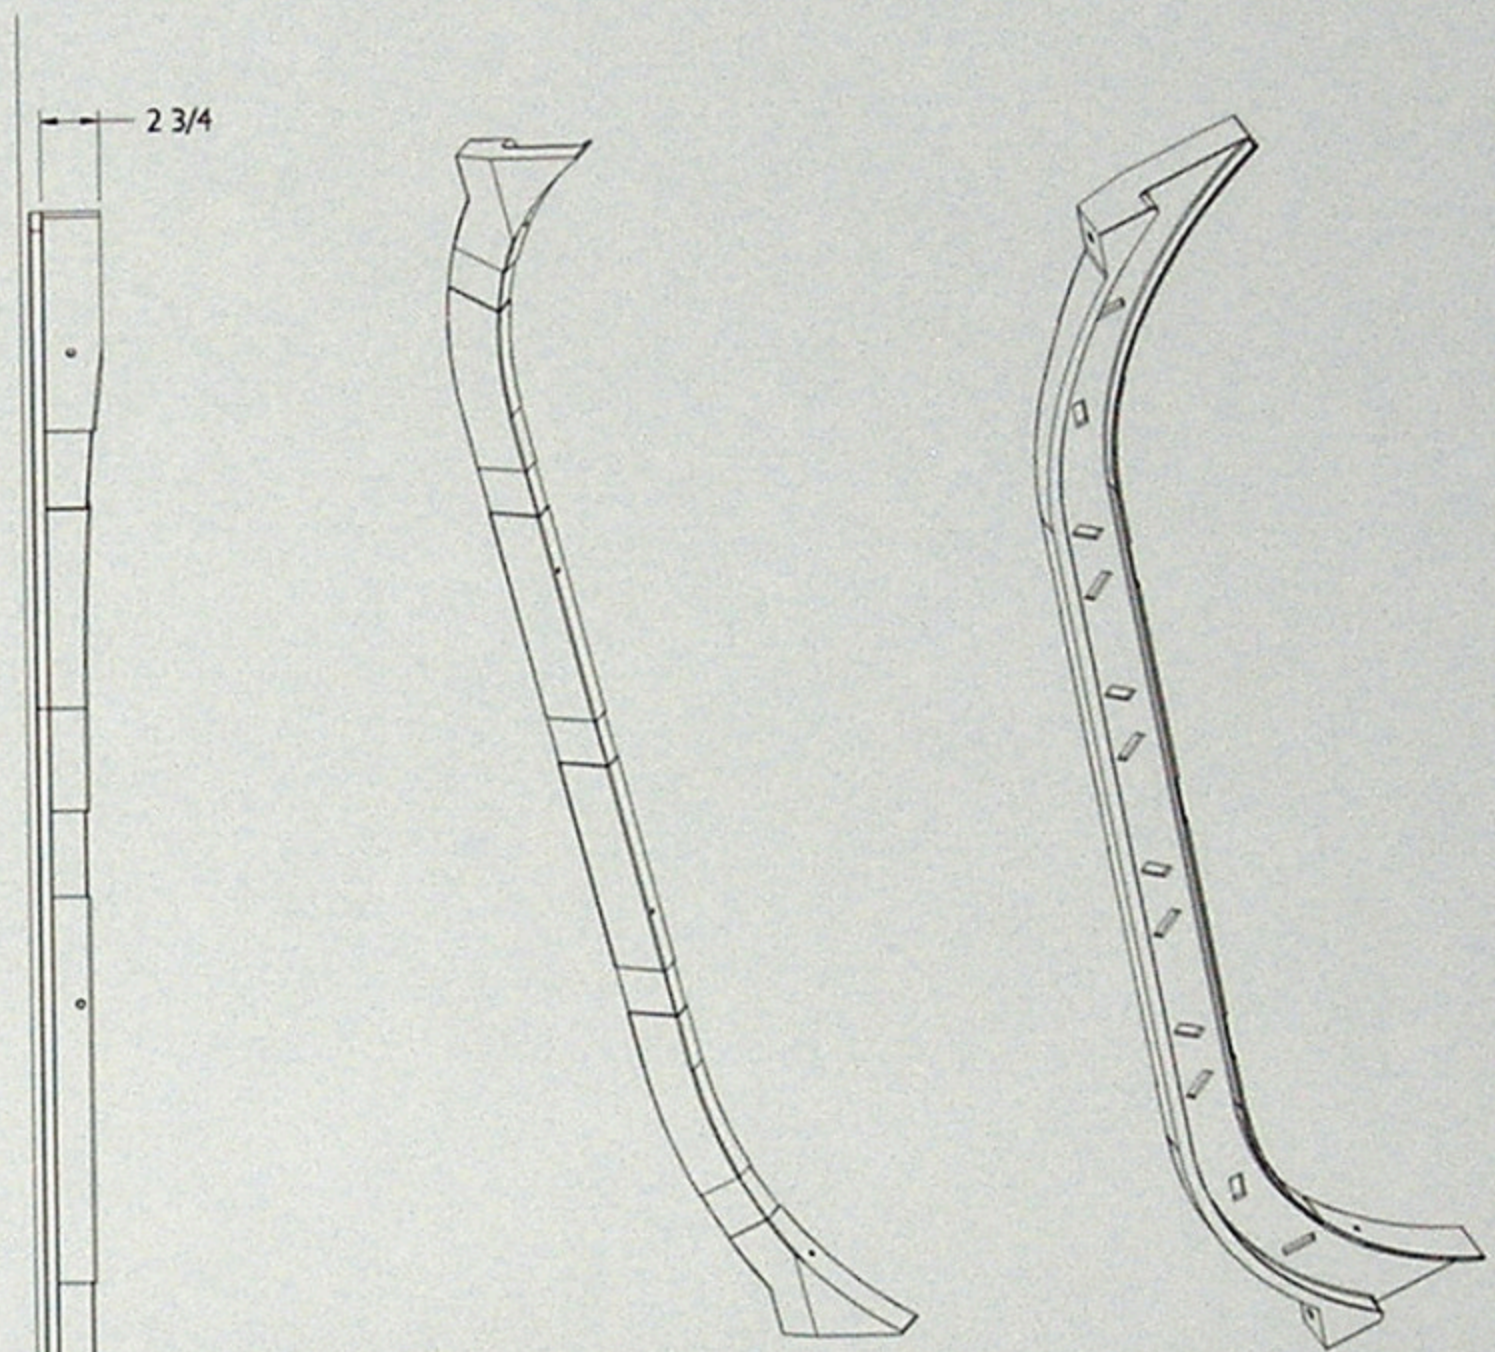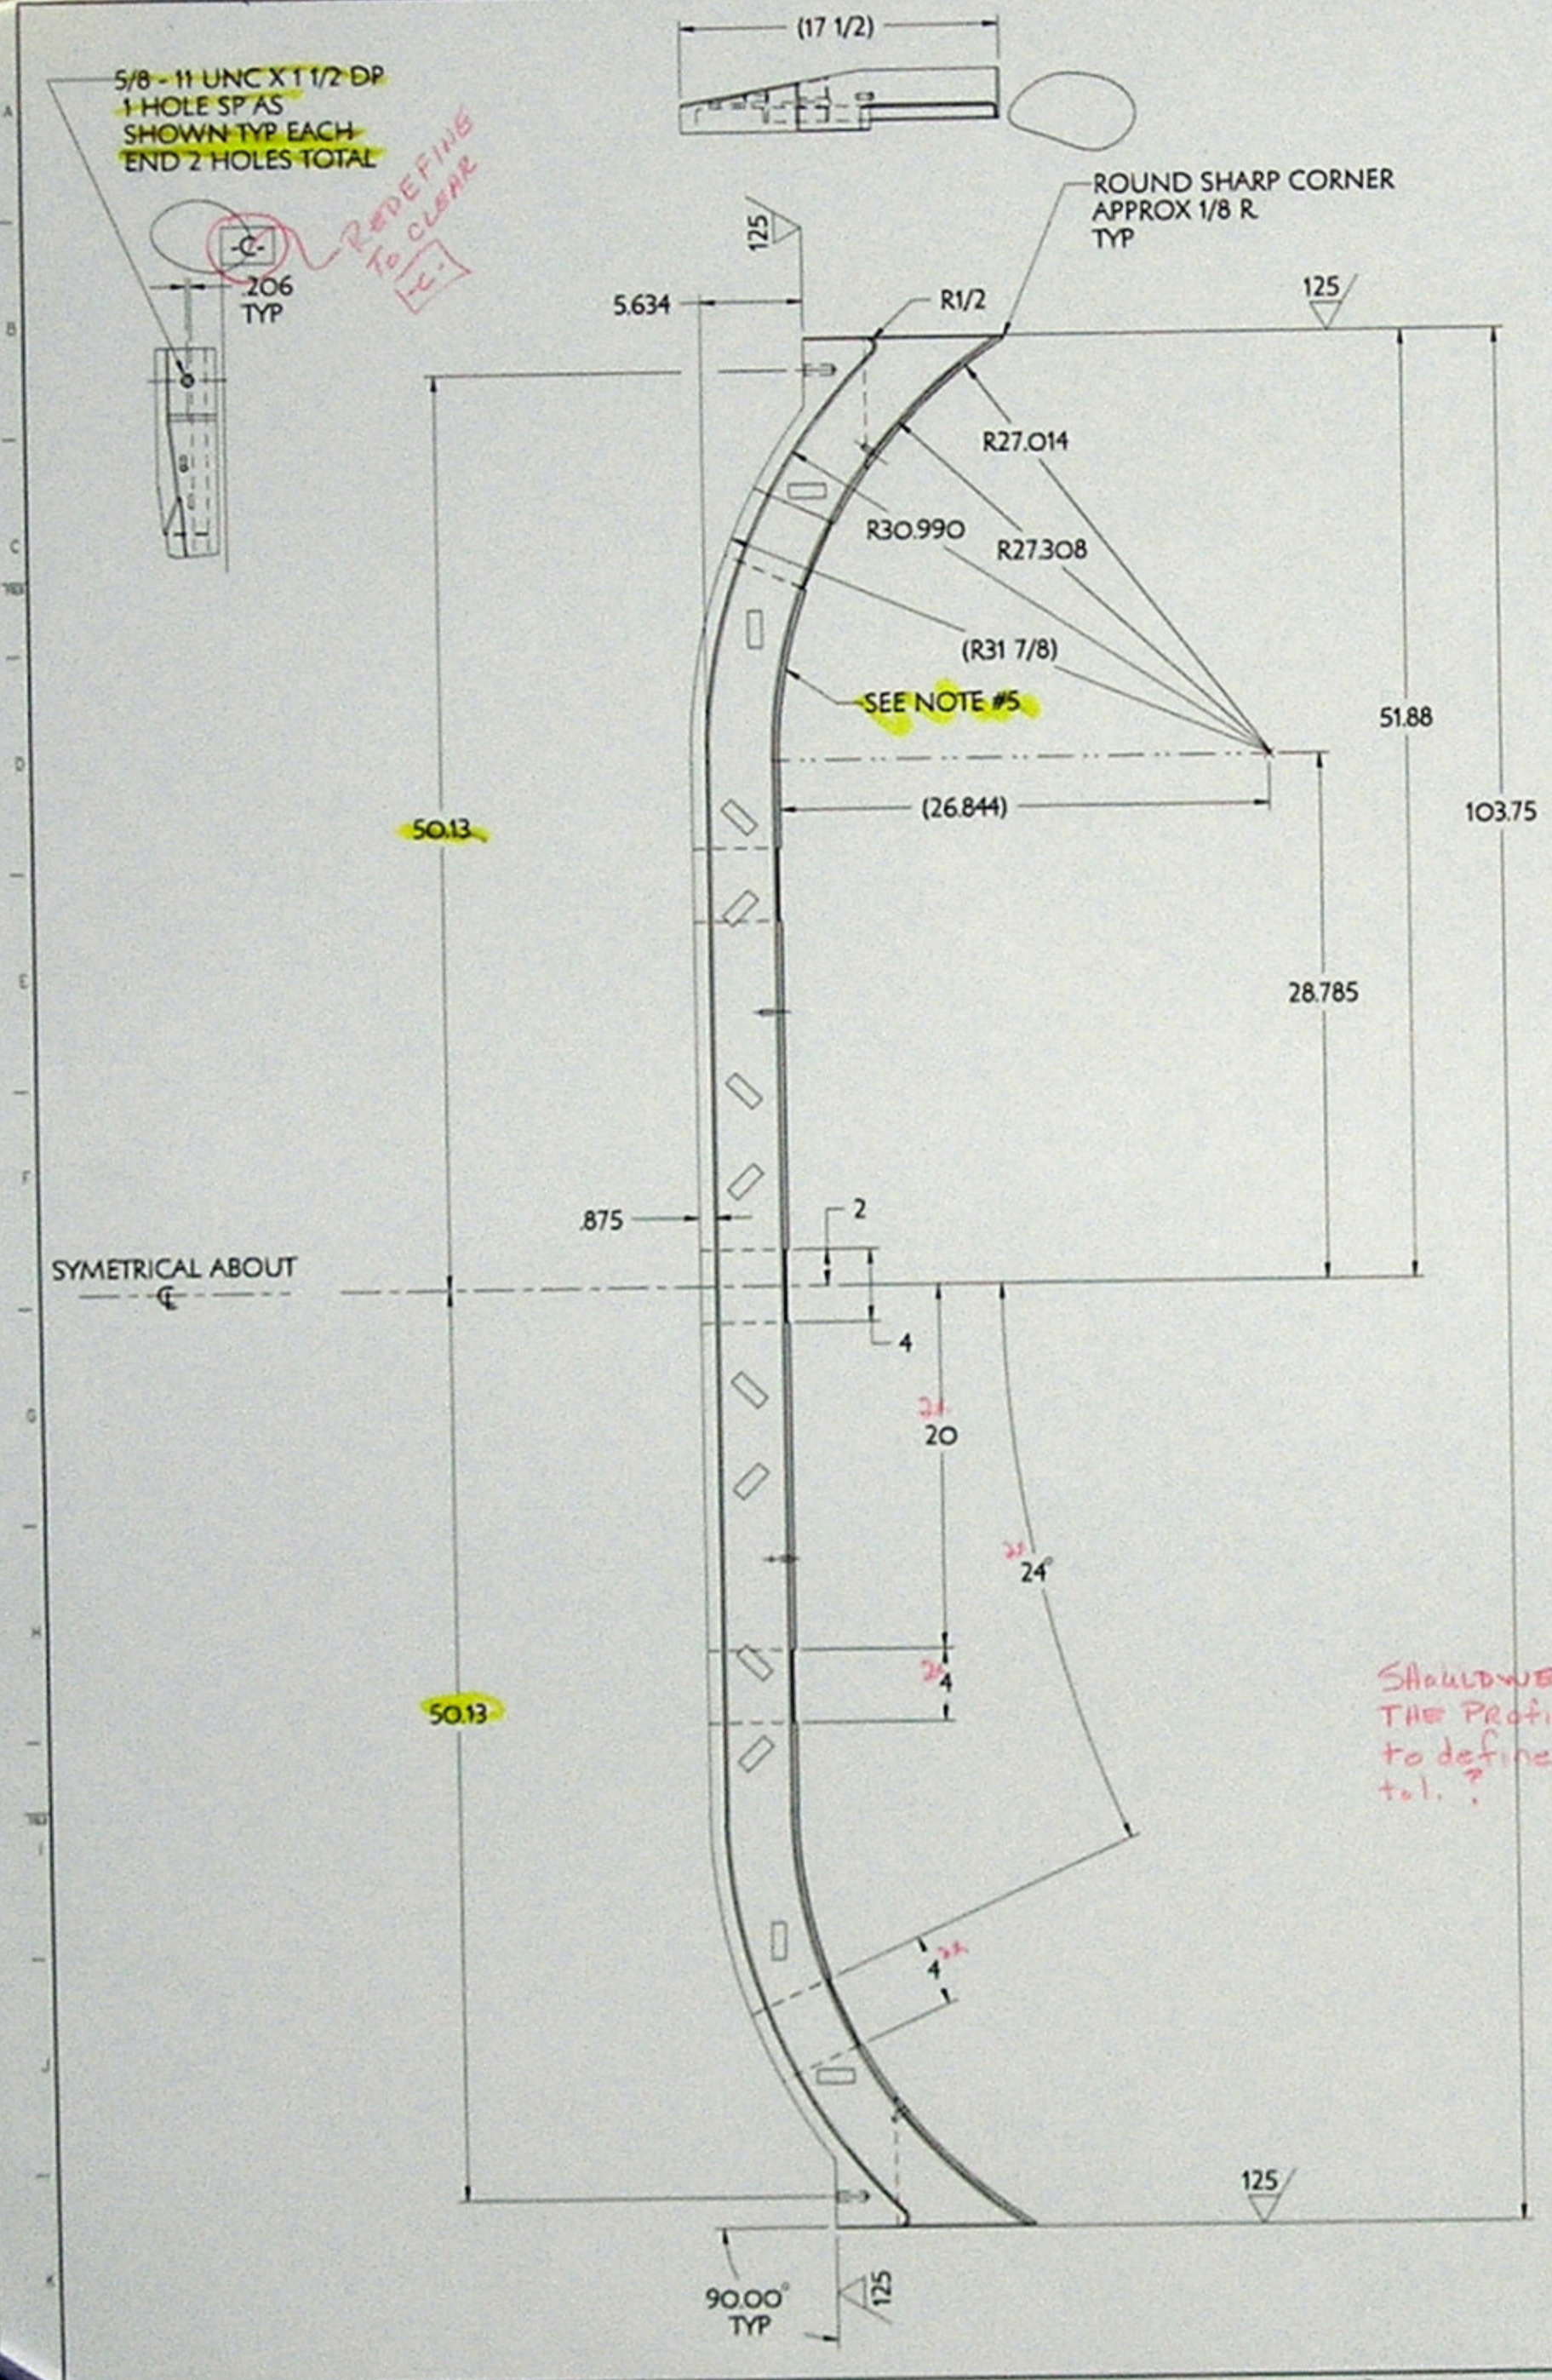

NOTES:

1. DIMENSIONS ARE IN INCHES
2. SEE SPECIFICATION, NCSX-CSPEC-131-03 IF CASTING PROCESS IS USED TO MANUFACTURE SEE SPECIFICATION NCSX-CSPEC-131-04 IF WELDMENT PROCESS IS USED TO MANUFACTURE
3. GEOMETRY IS DEFINED IN PRO ENGINEER CAD MODELS/FILES SE131-085.PRT
4. DRAWING AND CAD MODEL COMBINED DEFINE PART.
5. MACHINED FINISHED SURFACES TO CAD DATA. PROFILE TO BE WITHIN .020 UNLESS OTHERWISE SPECIFIED. PROFILE TOLERANCE IS BILATERAL ± 0.010 EITHER SIDE OF THE REFERENCED SURFACE.
7. SPOTFACE MIN. DIA/DEPTH AS REQ'D.
8. DIMENSIONS APPLY AT ROOM TEMPERATURE. OPERATING TEMPERATURE 80° K.


Should we use the Profile Symbol to define the tol.?

*UN5531600 or specified in Spec or...
Dwg should be saved with layers deleted*

RELEASE LEVEL: WIP
DWG VERSION NO: 2

PART NO.	SE131-085	TF COIL WEDGE STRUCTURE	QTY REQD	36
DRAWING NO.		NOMENCLATURE OR DESCRIPTION	MATERIAL	
PARTS LIST				
COMPUTER GENERATED DRAWING	SE131-085	PRINCETON PLASMA PHYSICS LABORATORY		
MANUAL CHANGES NOT PERMITTED		PRINCETON UNIVERSITY		
		NATIONAL COMPACT STELLARATOR EXPERIMENT		
		STELLARATOR CORE		
		CONVENTIONAL COILS		
		TF COIL WEDGE STRUCTURE (DETAIL)		
WEIGHT	192.4 LBS			
MODEL NAME	SE131-085			
SCALE	0.250			
SCALE ASSEMBLY				
DESIGNED BY	J. BIERER	CHKD BY	M. KALISH	
DRAWN BY	J. BIERER	APP'D BY	M. KALISH	
				SE131-085
				SHEET 1 OF 2

NO.	REVISION	BY	CHK	SUP	APPROVED	DATE
1	REVISED PER ECH #5073	JDR	MK	JS	M. KALISH	2/03/06

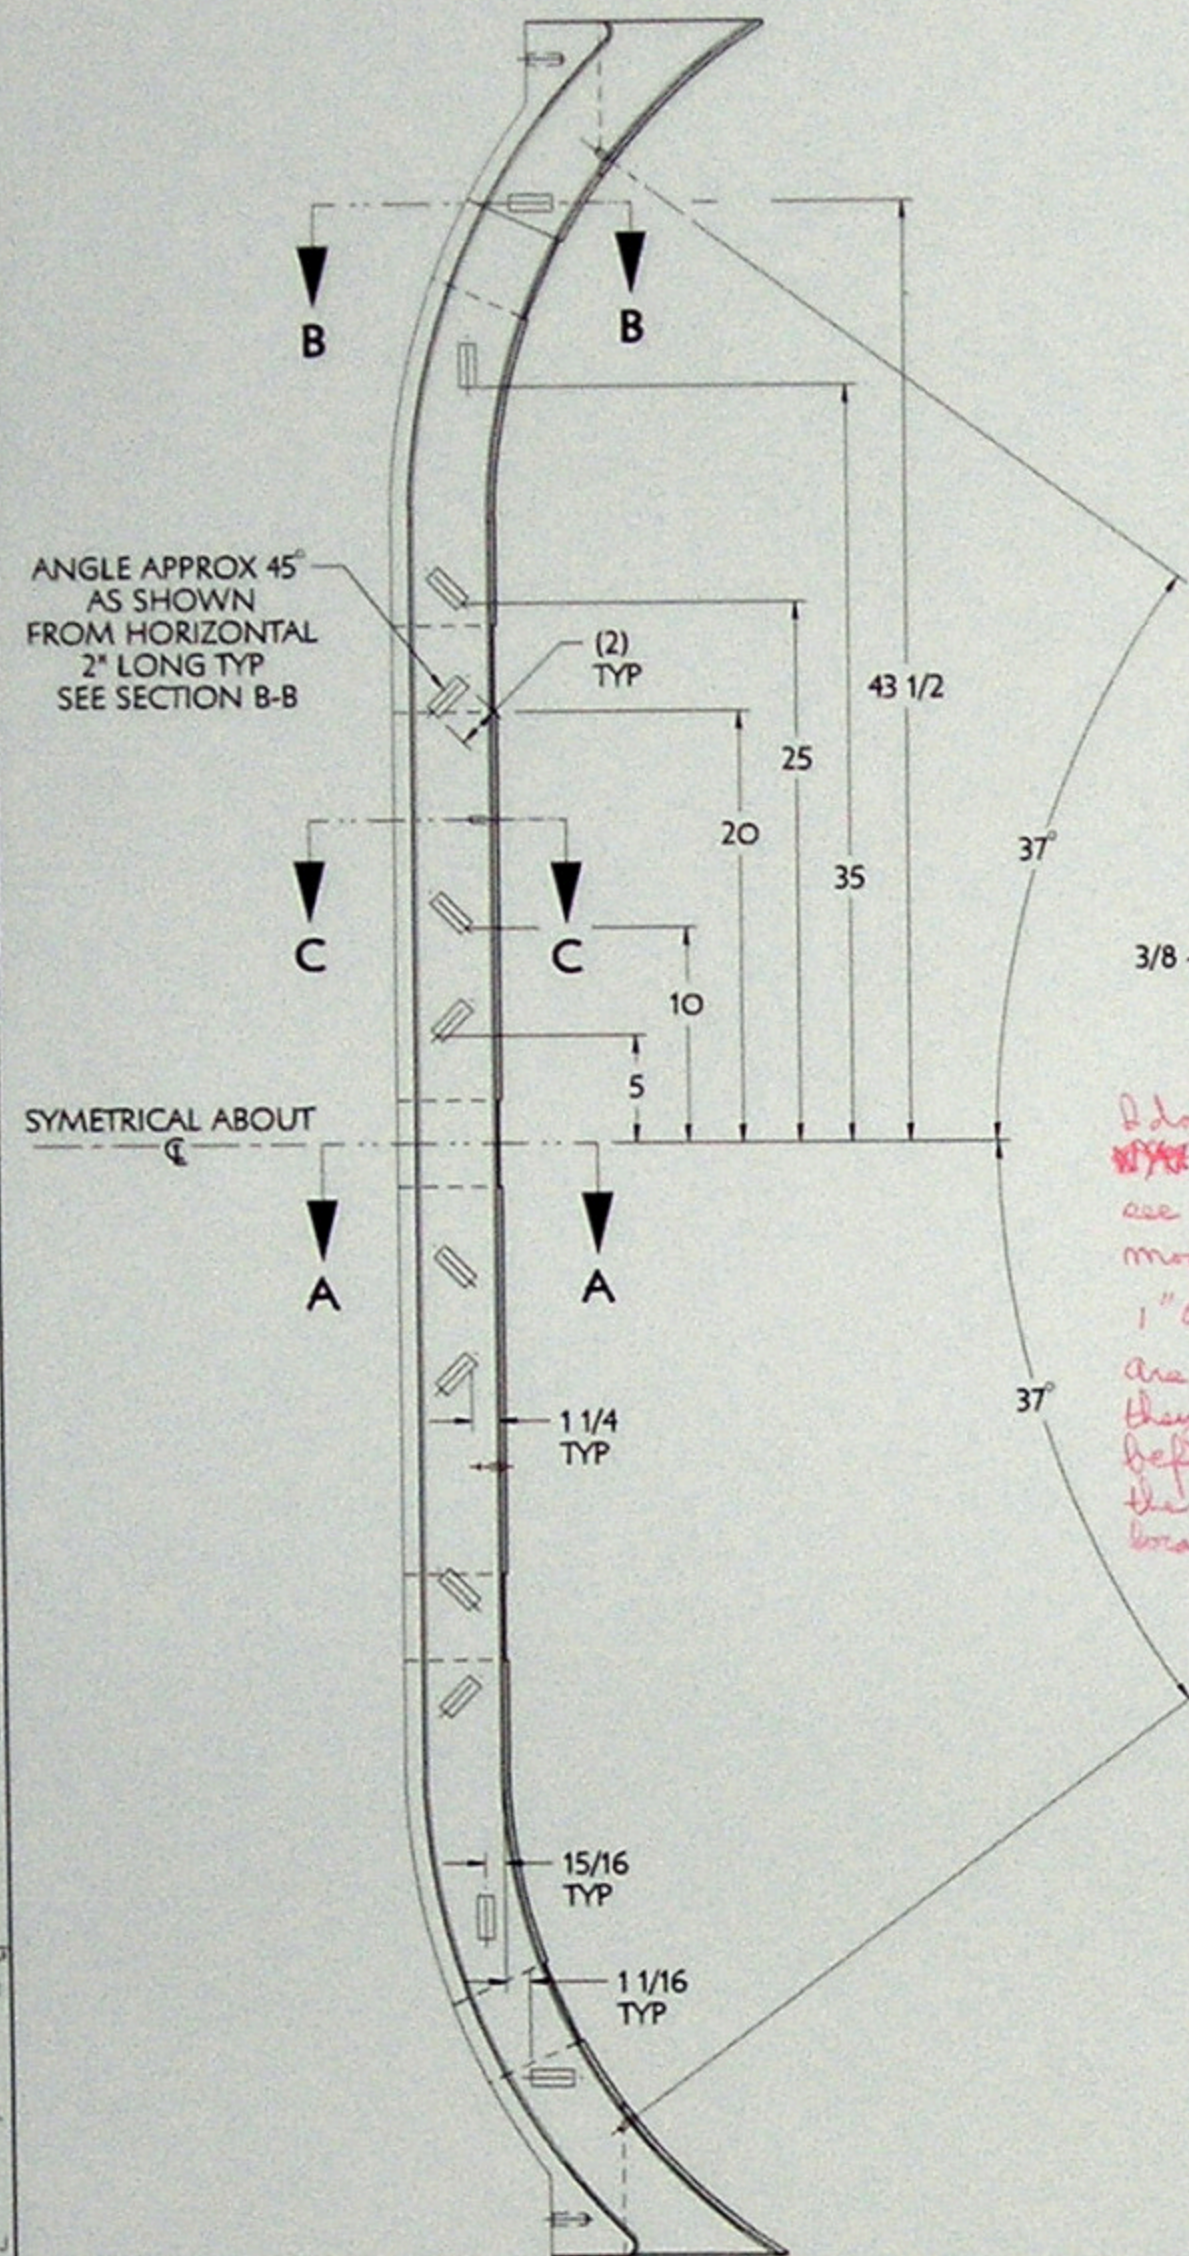


ANGLE APPROX 45° AS SHOWN FROM HORIZONTAL 2" LONG TYP SEE SECTION B-B


SYMMETRICAL ABOUT

3/8 - 16 UNC X 1 1/4 DP TYP 4 HOLES SP AS SHOWN SEE NOTE #7

I don't see any SPOTFACE. I didn't see any in the model either. 1" Ø SPOTFACE? Are you assuming they will spotface before they drill the hole so that the hole is better located the feature?

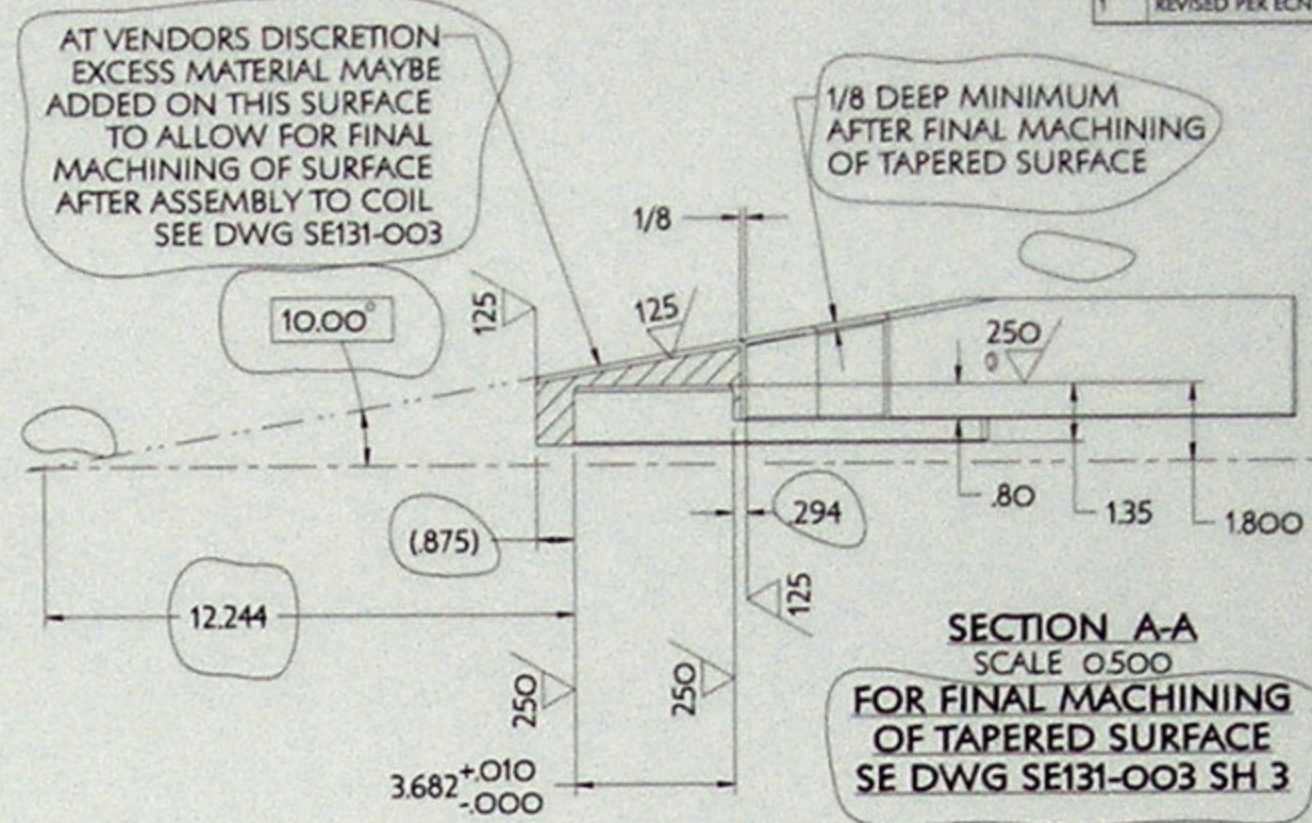


SECTION A-A
SCALE 0.500
FOR FINAL MACHINING OF TAPERED SURFACE SE DWG SE131-003 SH.3

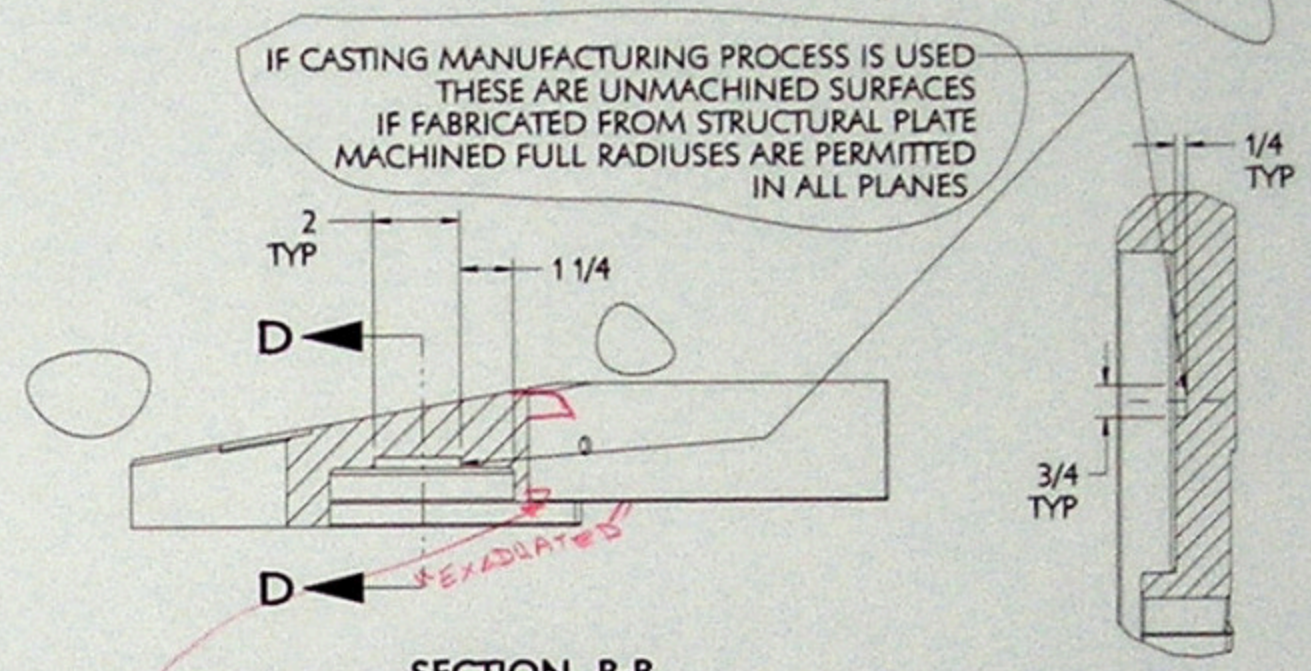

SECTION B-B
SCALE 0.500

This section and the model are a little different. A surface in the model looks like this sweeps out a little.

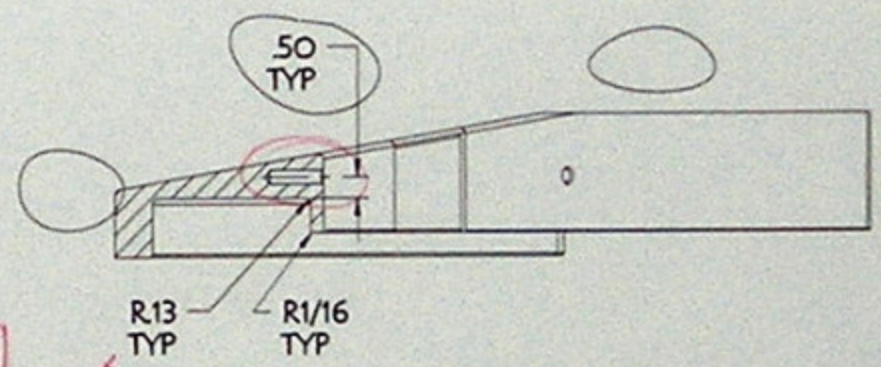

SECTION C-C
SCALE 0.500

SECTION D-D
SCALE 0.500

PART NO.	DRAWING NO.	NOMENCLATURE OR DESCRIPTION	MATERIAL	QTY	REGR.
PARTS LIST					
COMPUTER GENERATED DRAWING MANUAL CHANGES NOT PERMITTED	CENTRAL FILE: UNLESS OTHERWISE SPECIFIED	PRINCETON PLASMA PHYSICS LABORATORY PRINCETON UNIVERSITY NATIONAL COMPACT STELLARATOR EXPERIMENT			
Fig. 6	DIMENSIONS ARE IN INCHES MACHINE SURFACES UNLESS OTHERWISE SPECIFIED	STELLARATOR CORE CONVENTIONAL COILS TF COIL WEDGE STRUCTURE DETAIL			
NO. OF HOLES BY SEALING DRILL	BREAK SHARP CORNERS, CHAMFER	TOLERANCES - NON-CUMULATIVE	DRN: J. RUSHIKAKI	8/01/05	DRAWING NO.
SCALE 0.500	DECIMALS FRACTIONS	CHR: M. KALISH	8/01/05	SE131-085	
NEXT ASSEMBLY	ALL DIMENSIONS ARE IN INCHES UNLESS OTHERWISE SPECIFIED	ENR: M. KALISH	8/01/05	SHEET 2 OF 2	
WELDING ENGINEER	APPROVED BY: J. SIEGEL	SUPV: J. SIEGEL	8/01/05	REV: 1	

RELEASE LEVEL: WIP
DWG VERSION NO: 2

NCSK SE131-085